

CERTIFIED RECORD OF LAND CORNER MONUMENTATION


History of original corner establishment:

Corner originally established by W.B. Barr under GLO contract number 503, dated August 9, 1884. Surveyor General record states:

Set limestone 16x10x10 ins., 11 inches in the ground for 1/4 sec. cor. marked 1/4 on the W. side, from which;
 A pine 36 ins. diam. bears N85°W, 25 lks. dist. marked 1/4 S BT
 A pine 12 ins. diam. bears S14 1/2°E, 97 lks. dist. marked 1/4 S BT

Corner remonumented at proportionate position in 1984 by Barry B. Barbour, OPLS 1051. His record states:

Found no trace of record stone or bearing trees. Corner falls near a road and logged area. At surveyed point set 2 1/2"x30" aluminum pipe and cap marked: (markings shown below). Set pipe 20" in the ground and mound of stone around to cap. From which by magnetic declination of N20°E:
 An 18" Pine bears N30°E, 11.0 ft. scribed 1/4 S22 BT.
 An 18" Pine bears S65°W, 76.6 ft. scribed 1/4 S21 BT.
 Painted blazes red and 6" red band around. Placed 54-3s, 54-4s and brass washers stamped PLS 1051 on the bearing trees. Placed a 54-4 on a steel fencepost 5' North of the corner.

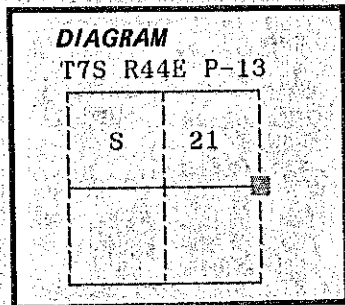

No record of subsequent monumentation found in Baker County survey records.

Description of corner evidence found:

Found aluminum monument erroneously set by Mr. Barbour at proportionate position. Found corner accessories established by Barbour as described above. Monument is marked as shown:

At a point approximately 70 feet South and 210 feet West of the Barbour monument, I found the original corner stone set by Mr. Barr.

Found a limestone 16x9x8 inches marked 1/4 on West face.

Found the rotted remains of a large Ponderosa Pine N85°W, 25 lks, no scribes or blaze visible.

Found no evidence of the original Southeast bearing tree.

T7S R44E
 1/4
 S 21 | S 22
 OR PLS 1051
 1984

Description of monument and accessories established to perpetuate the

original location of this corner: In place of the found original corner stone, I set a 2 1/2" x 30" aluminum pipe with aluminum cap marked as shown, 27 inches in the ground, from which:

New BTs:
 A 17 inch diameter Ponderosa Pine bears N38°E, 21.32 feet marked 1/4 S22 BT
 A 8 inch diameter Douglas Fir bears S4°W, 23.22 feet marked 1/4 S21 BT


Painted a 6 inch red band around all BTs and attached bearing tree and land survey monument signs.

Set a steel fencepost approximately 5 feet North with land survey monument sign attached.

Buried the original corner stone South and alongside of monument.

I hereby certify that the above corner point was perpetuated as hereon described on September 26, 1988.

Witness: Rick Robinson

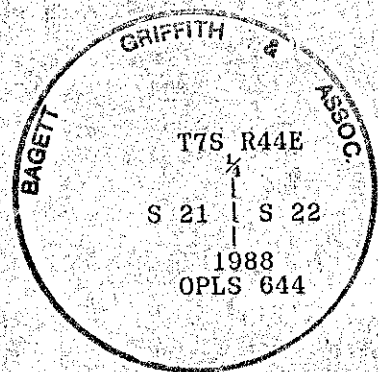

**REGISTERED
 PROFESSIONAL
 LAND SURVEYOR**

OREGON
 JULY 10, 1964
DUANE I. GRIFFITH
 644

I used a steel tape and magnetic compass in the establishment of new accessories. I used 20° East magnetic declination and the distances are to a 50d spike driven in the right side of the root crown. I attached a brass washer marked OPLS 644 to the BT blaze.

Office of..... County of.....
 State of..... I hereby certify that the within instrument was filed in this office
 for record on the..... day of....., 19.....

..... by
 (COUNTY OFFICIAL) (DEPUTY)

P-13
 FILED 11-16-88
 BAKER COUNTY SURVEYOR
 SURVEY NO. 7-44-224