

CERTIFIED RECORD OF LAND CORNER MONUMENTATION

History of original corner establishment:

Original corner set by Barry B. Barbour, LS 1051, during survey filed with the Baker County Surveyor, file No. 7-44-78, said survey subsequently CANCELLED.

Record states:

At surveyed point set 2½" x 30" aluminum pipe and cap, set pipe 25" in the ground and mound of stone around cap.

From which:

A fir, 14 ins. diam., bears S. 42° E., 19.1 ft. dist., scribed E/E 1/64 S33 BT.

A fir, 10 ins. diam., bears N. 31° W., 72.9 ft. dist., scribed E/E 1/64 S33 BT.

Both bearing trees have brash washers stamped PLS 1051.

Corner reestablished by Rick E. Tawney, et al, under Group No. 1554, approved April 21, 1992.

Record states


Set a stainless steel post, 28 ins. long, 2½ ins. diam., 24 ins. in the ground, with brass cap.

From which bearing trees mkd. by Barbour

A fir snag, 13 ins. diam., bears S. 48° E., 46½ lks. dist., with scribe marks on partially healed blaze.

A fir, 11 ins. diam., bears N. 29° W., 107½ lks. dist., with scribe marks on partially healed blaze.

Aluminum cap stamped by Barbour, PLS 1051, bears N. 73°15'00" W., 0.040 chs. dist.

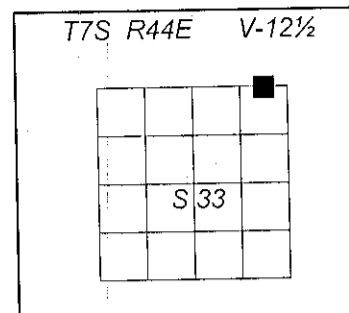

Description of corner evidence found:

Found a 2½ ins. diam. steel pipe with a 3¼ ins. diam. brass cap, mkd. as shown, firmly set, flush with the ground,

From the recovered monument I find the bearing trees mkd. by Barbour

A fir snag, 14 ins. diam., bears S. 28° E., 17.5 ft. dist., with visible scribe on open blaze. (S48°E, 46½ lks., Tawney)

A Douglas fir, 16 ins. diam., alive & healthy, bears N. 29° W., 74.7 ft. dist., with visible scribe on open blaze. (107½ lks., Tawney)

Found a guard post 5 ft. North of recovered monument with Land Survey Monument (54-9) sign.

Found Barbour cap West, 2.6 ft. from recovered monument.

Description of monument and accessories I established to perpetuate original location of this corner:

New accessory

Chiseled an X into westerly face of 5 ft. x 10 ft. x 5 ft. boulder outcrop, bears N. 87° E., 23.5 ft. dist.

CORS '02 geographic position:


Lat. 44°55'10.9" N
Long. 117°19'21.6" W

All bearing trees are painted with red bands, and have Bearing Tree (54-3) and Land Survey Monument (54-9) signs attached.

Posted National Forest Boundary S. 8°10'16" W. and N. 9°46'08" W. from corner with Property Boundary (54-2) signs, and a Land Survey Monument (54-9) sign on nearby post.

Witnesses: Kristina Powell and Matt Brockamp

Date: August 25, 2009

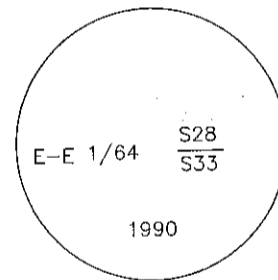

REGISTERED
PROFESSIONAL
LAND SURVEYOR

Ron Walter
OREGON
JANUARY 18, 1994
RON C. WALTER
2648

Renewal Date: June 30, 2010

Office of County Surveyor County of Baker
State of Oregon , I hereby certify that the within instrument was filed in this office
for record on the day of , 20
..... by
(COUNTY OFFICIAL) (DEPUTY)

FILED Feb 24, 2010

BAKER COUNTY SURVEYOR

SURVEY NO. 7-44-232