

CERTIFIED RECORD OF LAND CORNER MONUMENTATION

History of original corner establishment:


Original corner set by Barry B. Barbour, LS 1051, during survey filed with the Baker County Survey, file No. 7-44-78, said survey subsequently CANCELLED.

Record states:

At surveyed point set 2½" x 30" aluminum pipe and cap, set pipe 25" in the ground and mound of stone around cap.

From which:

- A fir, 10 ins. diam., bears N. 52° E., 14.6 ft. dist., scribed C/E/E/NE 1/256 S33 BT.
 - A fir, 6 ins. diam., bears S. 2° E., 22.9 ft. dist., scribed C/E/E/NE 1/256 S33 BT.
- Both bearing trees have brush washers stamped PLS 1051.

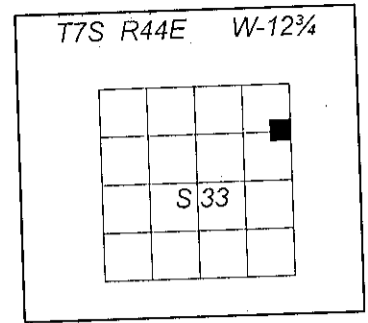

Corner reestablished by Rick E. Tawney, et al, under Group No. 1554, approved April 21, 1992.

Record states

Set a stainless steel post, 28 ins. long, 2½ ins. diam., 22 ins. in the ground, in a collar of stone, with brass cap.

From which bearing trees mkd. by Barbour

- A fir, 9 ins. diam., bears N. 42¼° E., 19 lks. dist., with scribe marks on partially healed blaze.
- A fir, 7 ins. diam., bears S. 5¼° W., 36 lks. dist., with scribe marks on partially healed blaze.

Aluminum cap stamped by Barbour, PLS 1051, bears S. 76°07'00" W., 0.045 chs. dist.

Description of corner evidence found:


Found a 2½ ins. diam. steel pipe with a ¾ ins. diam. brass cap, mkd. as shown, firmly set, flush with ground, in a rock collar,

From the recovered monument I find the bearing trees mkd. by Barbour

- A fir, 10 ins. diam., dead & down, bears N. 42¼° E., 12.5 ft. dist., with visible scribe on open blaze.
- A fir, 9 ins. diam., dead & down, bears S. 5¼° W., 23.8 ft. dist., with visible scribe on open blaze.

Found guard post 5 ft. south with Land Survey Monument (54-9) sign.

Found Barbour pipe, no cap, 3.0 ft., S. 76° W from recovered monument.

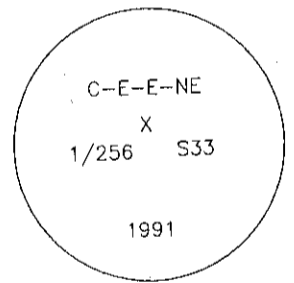

Description of monument and accessories I established to perpetuate original location of this corner:

New bearing trees

- A Douglas fir, 9 ins. diam., bears N. 26° E., 20.9 ft. dist., mkd. X BT, on double blaze, with washer in side center.
- A Douglas fir, 13 ins. diam., bears S. 42° E., 21.6 ft. dist., mkd. 1/256 S33 BT, with washer on side center.

CORS '02 geographic position:

Lat. 44°54'57.8" N
Long. 117°19'20.7" W

All bearing trees are painted with red bands, and have Bearing Tree (54-3) and Land Survey Monument (54-9) signs attached. All new bearing trees have a metal washer stamped "LS 2648" nailed in the side center.

Posted National Forest Boundary N. 89°51'21" W. and S. 7°59'31" W. from corner with Property Boundary (54-2) signs, and a Land Survey Monument (54-9) sign on nearby post.

Witnesses: Kristina Powell, Matt Brockamp and Nick Tressler

Date: August 20, 2009

REGISTERED
PROFESSIONAL
LAND SURVEYOR

Ron C. Walter

OREGON
JANUARY 18, 1994
RON C. WALTER
2648

Renewal Date: June 30, 2010

Office of County Surveyor County of Baker
State of Oregon , I hereby certify that the within instrument was filed in this office
for record on the day of , 20
..... by
(COUNTY OFFICIAL) (DEPUTY)

FILED Feb. 24, 2010