

CERTIFIED RECORD OF LAND CORNER MONUMENTATION

History of original corner establishment:

Original corner set by Barry B. Barbour, LS 1051, during survey filed with the Baker County Surveyor, file No. 7-44-75, said survey subsequently CANCELLED.

Record states:

At surveyed point set 2½" x 30" aluminum pipe and cap, set pipe 24" in the ground. No rock in the area.

From which:

A fir, 6 ins. diam., bears N. 3½° E., 29.9 ft. dist., scribed N1/16 S34 BT.

A pine, 8 ins. diam., bears S. 56° W., 27.1 ft. dist., scribed N1/16 S33 BT.

Both bearing trees have brass washers stamped PLS 1051.

Corner reestablished by Rick E. Tawney, et al, under Group No. 1554, approved April 21, 1992.

Record states


Set a stainless steel post, 28 ins. long, 2½ ins. diam., 22 ins. in the ground, in a mound of stone, with brass cap.

From which bearing trees mkd. by Barbour

A pine, 8 ins. diam., bears S. 57¼° W., 45½ lks. dist., with scribe marks on partially healed blaze.

A fir, 6 ins. diam., bears N. 3¼° W., 42½ lks. dist., with scribe marks on partially healed blaze.

Aluminum cap stamped by Barbour, PLS 1051, bears S. 77°33'00" W., 0.050 chs. dist.

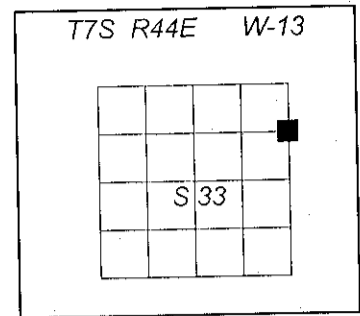

Description of corner evidence found:

Found a 2½ ins. diam. steel pipe with a ¾ ins. diam. brass cap, mkd. as shown, firmly set, flush with ground,


From the recovered monument I find the bearing trees mkd. by Barbour

A pine snag, 11 ins. diam., bears S. 57¼° W., 30.0 ft. dist., with visible scribe on open blaze.

A fir, 6 ins. diam., dead & down, bears N. 3¼° W., 28.1 ft. dist., with visible scribe on open blaze.

Found guard post 5 ft. South of recovered monument with Land Survey Monument (54-9) sign.

Found Barbour cap, 3.3 ft., S. 77½° W. from recovered monument.

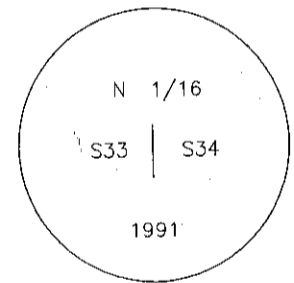

Description of monument and accessories I established to perpetuate original location of this corner:

New bearing trees

A Douglas fir, 11 ins. diam., bears N. 36° E., 28.5 ft. dist., mkd. X BT, on double blaze, with washer on side center.

A Douglas fir, 10 ins. diam., bears S. 80° E., 24.3 ft. dist., mkd. N 1/16 S34 BT, with washer on side center.

CORS '02 geographic position:

Lat. 44°54'58.0" N
Long. 117°19'16.6" W

All bearing trees are painted with red bands, and have Bearing Tree (54-3) and Land Survey Monument (54-9) signs attached. All new bearing trees have a metal washer stamped "LS 2648" nailed in the side center.

Witnesses: Kristina Powell and Matt Brockamp

Date: August 26, 2009

REGISTERED
PROFESSIONAL
LAND SURVEYOR

Ron Walter

OREGON
JANUARY 18, 1994
RON C. WALTER
2648

Renewal Date: June 30, 2010

Office of _____ County Surveyor _____ County of _____ Baker _____
State of _____ Oregon _____, I hereby certify that the within instrument was filed in this office
for record on the _____ day of _____, 20 _____
_____ by _____
(COUNTY OFFICIAL) (DEPUTY)

FILED Feb 24, 2010

BAKER COUNTY SURVEYOR

SURVEY NO. 7-44-236