


CERTIFIED RECORD OF LAND CORNER MONUMENTATION

History of original corner establishment:

Corner not previously monumented. The position of this corner is established by the methods and procedures defined in the U.S. Bureau of Land Management, Manual of Survey Instructions '73 (Manual), and as shown on Record of Survey filed with the Baker County Surveyor as CS -----.

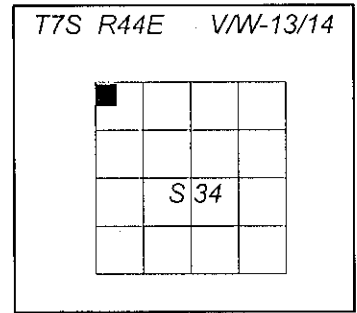

Description of corner evidence found:

None.

Description of monument and accessories I established to perpetuate original location of this corner:

At the position determined by survey, Willowa County Survey No. -----:

Set a 3¼ ins. diam. alum. cap on a 2½ ins. diam. alum. post, 30 ins. long, buried 16 ins. in the ground, with 3' diam. stone mound, and clear DEEP-1 magnet at base, mkd. as shown:

From which

A ponderosa pine, 24 ins. diam., bears N. 55½° E., 56.8 ft. dist., mkd. X BT, on double blaze, with washer in side center.

A ponderosa pine, 28 ins. diam., bears N. 18° W., 78.2 ft. dist., mkd. X BT, on double blaze, with washer in side center.

CORS '02 geographic position:


Lat. 44°55'06.6" N
Long. 117°19'10.6" W

All bearing trees are painted with red bands, and have Bearing Tree (54-3) and Land Survey Monument (54-9) signs attached. All new bearing trees have a metal washer stamped "LS 2648" nailed in the side center.

Posted National Forest Boundary N. 89°49'50" W. and S. 7°42'41" W. from corner with Property Boundary (54-2) signs, and a Land Survey Monument (54-9) sign on nearby post.

Witnesses: Ron Walter and Nick Tressler

Date: August 21, 2009

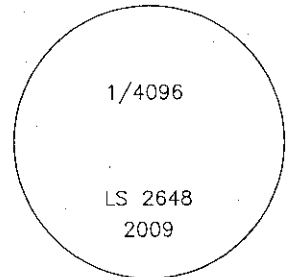

REGISTERED
PROFESSIONAL
LAND SURVEYOR

OREGON
JANUARY 18, 1994
RON C. WALTER
2648

Renewal Date: June 30, 2010

Office of County Surveyor County of Baker

State of Oregon, I hereby certify that the within instrument was filed in this office
for record on the day of, 20

..... by

(COUNTY OFFICIAL) (DEPUTY)

FILED Feb. 24, 2010

BAKER COUNTY SURVEYOR

SURVEY NO. 7-44-238