

CERTIFIED RECORD OF LAND CORNER MONUMENTATION

History of original corner establishment:

Corner originally set by Barry B. Barbour, LS 1051, during survey filed with the Baker County Surveyor, file no. 7-44-78 said survey subsequently CANCELLED.

Record states:

At surveyed point set 2 1/2" x 30" aluminum pipe and cap, 22 ins. in the ground and mound of stone around to cap.

From which:

- A pine, 16 ins. diam., bears S. 84° E., 45.3 ft. dist., scribed WC S/S 1/64 S27 BT.
- A fir, 16 ins. diam., bears N. 63° W., 61.7 ft. dist., scribed WC S/S 1/64 S28 BT.

Both bearing trees have washers stamped PLS 1051.


Corner reestablished by Rick E. Tawney, et al, under Group No. 1554, approved April 21, 1992.

Record states:

Set a stainless steel post, 28 ins. long, 2 1/2 ins. diam., 2 ins. in the ground, to solid rock, in mound of stone, 3 1/2 ft. base to top, with brass cap.

There are no suitable accessories available.

Aluminum cap stamped by Barbour, PLS 1051, bears N. 37°46'00" E., 2.360 chs. dist.

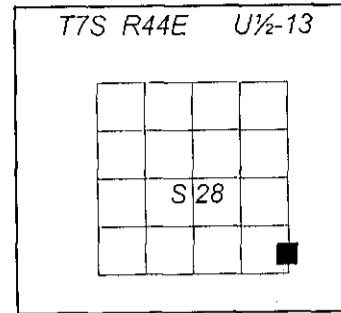

Description of corner evidence found:

Found a standard BLM 2 1/2 ins. diam. steel post with 3/4 ins. diam. brass cap, mkd. as shown, laying down, projecting 18 ins. above ground, with DEEP-1 clear magnet at base.

Description of monument and accessories I established to perpetuate original location of this corner:

Set 3/4 ins. diam. alum. cap on a 3/4 ins. diam. alum. drive rod, 36 ins. long, buried 28 ins. in the ground, bottom 16 ins. in concrete with 3 ft. diam. stone mound to top.

New accessories

- A 3" chiseled X BO, in south'ly rock face, 12 ft. high, bears S. 89 3/4° W., 21.8 ft. dist.
- A 3" chiseled X, in south'ly rock face, 4 ft. high, bears N. 3 1/4° W., 21.1 ft. dist.

CORS '02 geographic position:


Lat. 44°55'17.4" N
Long. 117°19'15.2" W

All bearing trees are painted with red bands, and have Bearing Tree (54-3) and Land Survey Monument (54-9) signs attached.

Posted National Forest Boundary N11°42'04"W and S89°21'05"E from corner with Property Boundary (54-2) signs, and a Land Survey Monument (54-9) sign on nearby post.

Witnesses: Ron Walter and Matt Brockamp

Date: August 25, 2009

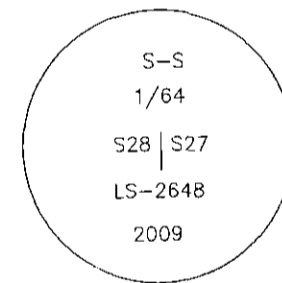

REGISTERED
PROFESSIONAL
LAND SURVEYOR

Ron Walter

OREGON
JANUARY 18, 1994
RON C. WALTER
2648

Renewal Date: June 30, 2010

Office of _____ County Surveyor _____ County of _____ Baker
State of _____ Oregon _____, I hereby certify that the within instrument was filed in this office
for record on the _____ day of _____, 20 _____
_____ by _____
(COUNTY OFFICIAL) (DEPUTY)

FILED Feb 24, 2010
BAKER COUNTY SURVEYOR
SURVEY NO. 7-44-237