

CERTIFIED RECORD OF LAND CORNER MONUMENTATION


History of original corner establishment:

Corner originally set by Rick E. Tawney, et al, under Group No. 1554, approved April 21, 1992.

Record states:

Set a stainless steel post, 28 ins. long, 2½ ins. diam., 21 ins. in the ground, with brass cap.

No accessories taken at the request of landowner.

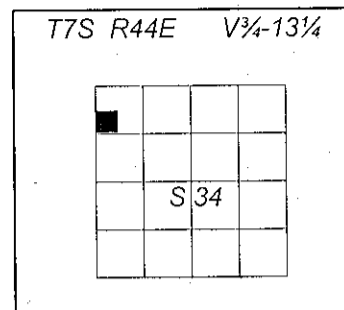

Description of corner evidence found:

Found a 2½ ins. diam. steel post with a ¾ ins. diam. brass cap, mkd. as shown, firmly set, projecting 2 ins. above ground with rock collar.

Description of monument and accessories I established to perpetuate original location of this corner:

New accessories

- A chiseled X, in the westerly face of rock outcrop, bears N. 60° E., 5.5 ft. dist.
- A chiseled XBO, in the westerly face of rock outcrop, bears S. 62° E., 29. ft. dist.


CORS '02 geographic position:

Lat. 44°55'00.5" N
Long. 117°19'11.6" W

Posted National Forest Boundary N. 7°42'41" E. and S. 89°49'06" E. from corner with Property Boundary (54-2) signs, and a Land Survey Monument (54-9) sign on nearby post

Witnesses: Kristina Powell, Nick Tressler and Matt Brockamp

Date: August 18, 2009

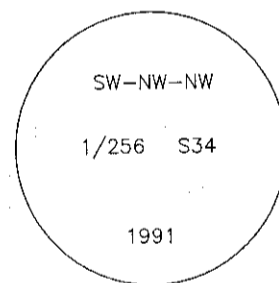

REGISTERED
PROFESSIONAL
LAND SURVEYOR

OREGON
JANUARY 18, 1994
RON C. WALTER
2648

Renewal Date: June 30, 2010

Office of _____ County Surveyor _____ County of _____ Baker _____
 State of _____ Oregon _____, I hereby certify that the within instrument was filed in this office
 for record on the _____ day of _____, 20 _____
 _____ by _____
 (COUNTY OFFICIAL) FILED Feb. 24, 2010 (DEPUTY)