

CERTIFIED RECORD OF LAND CORNER MONUMENTATION


History of original corner establishment:

Corner originally set by Rick E. Tawney, et al, under Group No. 1554, approved April 21, 1992.

Record states:

Set a stainless steel post, 28 ins. long, 2½ ins. diam., 24 ins. in the ground, with brass cap.

There were no accessories taken at the request of the landowner.

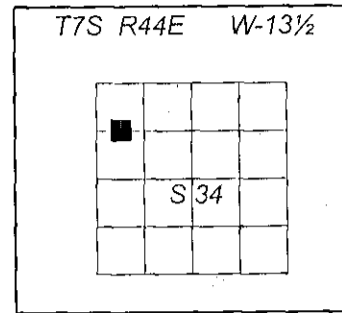

Description of corner evidence found:

Found a ¾ ins. diam. brass cap on a 2½ ins. diam. steel post, firmly set, flush with ground, mkd. as shown.

Description of monument and accessories I established to perpetuate original location of this corner:

New accessories

- A silver DEEP-1 magnet, bears N. 21 ¾° E., 11.6 ft. dist., buried 12 ins. in the ground.
- A blue DEEP-1 magnet, bears S. 40 ½° W., 14.7 ft. dist., buried 12 ins. in the ground.

Set a guard post 5 ft. from recovered monument with Land Survey Monument (54-9) sign.


CORS '02 geographic position:

- Lat. 44°54'57.5" N
- Long. 117°19'07.7" W

Posted National Forest Boundary N. 7°38'19" E. and N. 89°57'32" E. from corner with Property Boundary (54-2) signs, and a Land Survey Monument (54-9) sign on nearby post.

Witnesses: Matt Brockamp

Date: August 18, 2009

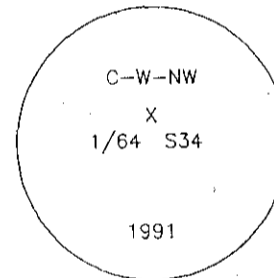

REGISTERED
PROFESSIONAL
LAND SURVEYOR

Ron Walter

OREGON
JANUARY 18, 1994
RON C. WALTER
2648

Renewal Date: June 30, 2010

Office of _____ County Surveyor _____ County of _____ Baker _____
 State of _____ Oregon _____, I hereby certify that the within instrument was filed in this office
 for record on the _____ day of _____, 20 _____
 _____ by _____
 (COUNTY OFFICIAL) (DEPUTY)

FILED Feb. 24, 2010

Form R6-7100-57 (9/71)

BAKER COUNTY SURVEYOR

SURVEY NO. 7-44-242

☆GPO --- 798-276