

**CERTIFIED RECORD OF LAND CORNER MONUMENTATION**

**History of original corner establishment:**

Corner originally set by Barry B. Barbour, LS 1051, during survey filed with the Baker County Surveyor, file no. 7-44-78 said survey subsequently CANCELLED.

Record states:

At surveyed point set 2½" x 30" aluminum pipe and cap, 14 ins. in the ground and mound of stone around to cap.

From which:

- A pine, 14 ins. diam., bears S. 70° E., 28.7 ft. dist., scribed C/S/NW 1/64 S34 BT.
- A pine, 12 ins. diam., bears N. 40° W., 54.0 ft. dist., scribed C/S/NW 1/64 S34 BT.

Both bearing trees have washers stamped PLS 1051.

Corner reestablished by Rick E. Tawney, et al, under Group No. 1554, approved April 21, 1992.


Record states:

Set a stainless steel post, 28 ins. long, 2½ ins. diam., 10 ins. in the ground, to solid rock, in mound of stone, 3 ft. base to top, with brass cap.

From which bearing trees mkd. by Barbour

- A pine, 13 ins. diam., bears S. 62½° E., 25½ lks. dist., with visible scribe on partially healed blaze.
- A pine, 12 ins. diam., bears N. 45½° W., 90 lks. dist., with visible scribe on partially healed blaze.

Aluminum cap stamped by Barbour, PLS 1051, bears N. 82°46'00" W., 0.060 chs. dist.

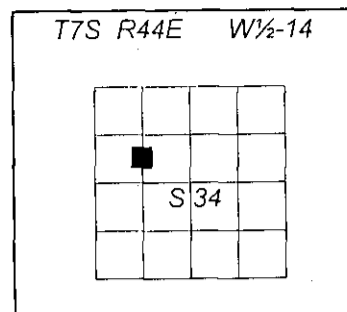

**Description of corner evidence found:**


True point for the C-S-NW 1/64 sec. cor. of sec. 34 is located in a pond, where it is impractical to establish a permanent monument.

Found a 2½ ins. diam. steel post with ¾ ins. diam. brass cap, loose, projecting 18 ins. above ground, with 3 ft. diam. stone mound, mkd. as shown.

From the recovered monument I find the bearing trees mkd. by Barbour

- A pine, 13 ins. diam., alive & sick, bears S. 66¼° E., 20.5 ft. dist., with visible scribe on open blaze. (S. 62½° E., 25½ lks., Tawney)
- A pine snag, bears N. 43° W., 56.4 ft. dist., with visible scribe on open blaze. (N. 45½° W., 90 lks., Tawney)

Found Barbour cap N. 82¾° W., 4.0 ft. from recovered monument.

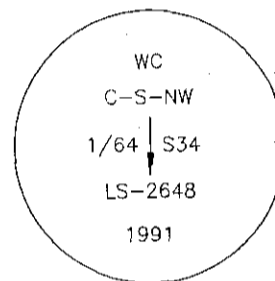

**Description of monument and accessories I established to perpetuate original location of this corner:**

New accessories

- A chiseled XBO, on top of 2' x 3' x 1' boulder outcrop, bears S. 2° E., 36.8 ft. dist.
- A chiseled X, in westerly face of 2' x 3' x 1' boulder outcrop, bears N. 14° W., 29.8 ft. dist.

Rebuild rock mound.

Set guard post 5 ft. from recovered monument with Land Survey Monument (54-9) sign.

CORS '02 geographic position:

- Lat. 44°54'52.3" N
- Long. 117°19'00.3" W

All bearing trees are painted with red bands, and have Bearing Tree (54-3) and Land Survey Monument (54-9) signs attached.

Posted National Forest Boundary N. 7°18'29" E. and N. 89°34'03" E. from corner with Property Boundary (54-2) signs, and a Land Survey Monument (54-9) sign on nearby post.

Witnesses: Matt Brockamp, Kristina Powell and Nick Tressler

Date: August 18, 2009

REGISTERED  
PROFESSIONAL  
LAND SURVEYOR

*Ron Walter*

OREGON  
JANUARY 18, 1994  
RON C. WALTER  
2648

Renewal Date: June 30, 2010

Office of \_\_\_\_\_ County Surveyor \_\_\_\_\_ County of Baker  
State of Oregon, I hereby certify that the within instrument was filed in this office  
for record on the \_\_\_\_\_ day of \_\_\_\_\_, 20 \_\_\_\_\_  
\_\_\_\_\_ by \_\_\_\_\_  
(COUNTY OFFICIAL) FILED Feb 24, 2010 (DEPUTY)