

**CERTIFIED RECORD OF LAND CORNER MONUMENTATION**


**History of original corner establishment:**

Original corner set by Rick E. Tawney, et al, under Group No. 1554, approved April 21, 1992.

Record states


Set a stainless steel post, 28 ins. long, 2 1/2 ins. diam., 24 ins. in the ground, with brass cap.

True point for the SW-SE-NW 1/256 sec. cor. of sec. 34, is located in a pond where it is impractical to establish a permanent monument.

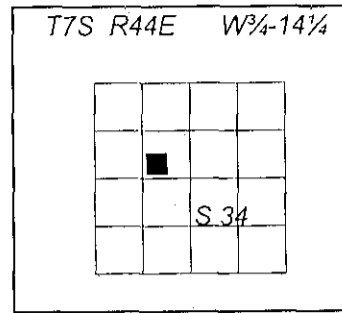

**Description of corner evidence found:**

Found a 2 1/2 ins. diam. steel pipe with a 3/4 ins. diam. brass cap, mkd. as shown, loose and out of position, with clear DEEP-1 magnet nearby, buried 6 ins. below ground.

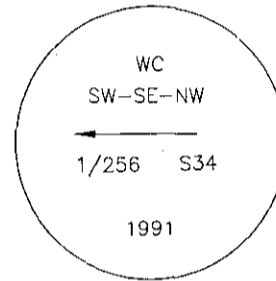

**Description of monument and accessories I established to perpetuate original location of this corner:**

Found location of clear DEEP-1 magnet using a total station to calculate the position. Repositioned monument at location of magnet, buried 6 ins. in the ground.

New bearing tree

A ponderosa pine, 19 ins. diam., bears N. 18 1/2° E., 18.7 ft. dist., mkd. X BT, on double blaze, with washer in side center.

New accessory

A chiseled XBO, in northeasterly face of rock outcrop, bears S. 49 1/2° E., 55.9 ft. dist.

CORS '02 geographic position:

Lat. 44°54'48.2" N  
Long. 117°18'56.2" W

All bearing trees are painted with red bands, and have Bearing Tree (54-3) and Land Survey Monument (54-9) signs attached. All new bearing trees have a metal washer stamped "LS 2648" nailed in the side center.

Posted National Forest Boundary N. 7°16'57" E. and N. 89°43'50" E. from corner with Property Boundary (54-2) signs, and a Land Survey Monument (54-9) sign on nearby post.

Witnesses: Kristina Powell, Matt Brockamp and Nick Tressler

Date: August 18, 2009

REGISTERED  
PROFESSIONAL  
LAND SURVEYOR

*Ron Walter*

OREGON  
JANUARY 18, 1994  
RON C. WALTER  
2648

Renewal Date: June 30, 2010

Office of ..... County Surveyor ..... County of ..... Baker .....

State of ..... Oregon ..... , I hereby certify that the within instrument was filed in this office

for record on the ..... day of ..... , 20 .....

..... by .....

(COUNTY OFFICIAL) (DEPUTY)

FILED Feb. 24, 2010

Form R6-7100-57 (9/71)

BAKER COUNTY SURVEYOR

☆GPO --- 798-278

SURVEY NO. 7-44-244