

CERTIFIED RECORD OF LAND CORNER MONUMENTATION


History of original corner establishment:

Corner originally set by Rick E. Tawney, et al, under Group No. 1554, approved April 21, 1992.

Record states:


Set a stainless steel post, 28 ins. long, 2½ ins. diam., 10 ins. in the ground, to solid rock, in a mound of stone, 3 ft. base, to top, with brass cap.

There were no accessories taken at the request of the landowner.

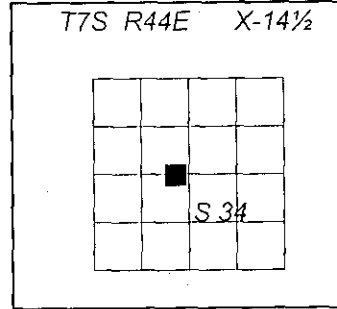

Description of corner evidence found:

Found a 2½ ins. diam. steel pipe with a 3¼ ins. diam. brass cap, mkd. as shown, firmly set, projecting 4 ins. above ground, with rock collar.

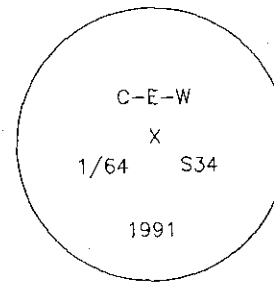

Description of monument and accessories I established to perpetuate original location of this corner:

New accessories

- A chiseled XBO, in westerly face of boulder, bears N. 35° E., 36.0 ft. dist.
- A chiseled XBO, in northerly face of cliff by pond, bears S. 5 ¼° E., 141.4 ft. dist.

Set guard post 5 ft. from recovered monument with Land Survey Monument (54-9) sign.

CORS '02 geographic position:

Lat. 44°54'45.3" N
Long. 117°18'53.0" W

Posted National Forest Boundary N. 6°51'20" E. and N. 89°30'02" E. from corner with Property Boundary (54-2) signs, and a Land Survey Monument (54-9) sign on nearby post.

Witnesses: Kristina Powell, Matt Brockamp and Nick Tressler

Date: August 18, 2009

REGISTERED
PROFESSIONAL
LAND SURVEYOR

OREGON
JANUARY 18, 1994
RON C. WALTER
2648

Renewal Date: June 30, 2010

Office of _____ County Surveyor _____ County of _____ Baker _____

State of _____ Oregon _____, I hereby certify that the within instrument was filed in this office

for record on the _____ day of _____, 20 _____

_____ by _____

(COUNTY OFFICIAL)

(DEPUTY)

FILED Feb. 24, 2010

Form R6-7100-57 (9/71)

BAKER COUNTY SURVEYOR

SURVEY NO. 7-44-246

☆GPO --- 798-276