

CERTIFIED RECORD OF LAND CORNER MONUMENTATION

History of original corner establishment:

Corner originally set by Rick E. Tawney, et al, under Group No. 1554, approved April 21, 1992.


Record states:

Point for the center S-SE-NW 1/256 sec. cor. of sec. 34, at its calculated position, which is occupied by a fir, 14 ins. diam.

Mark the fir CSSENW 1/256 S34 on the S. face and X on the N., E., and W. faces, for a corner tree.

From which

A stainless steel post, 28 ins. long, 2½ ins. diam., set 24 ins. in the ground, for a reference monument, bears S. 4° W., 13.4 lks. dist., with brass cap, mkd. RM C-S-SE-NW 1/256 S34 8.85 FT TO COR 1991 and an arrow pointing to the corner.

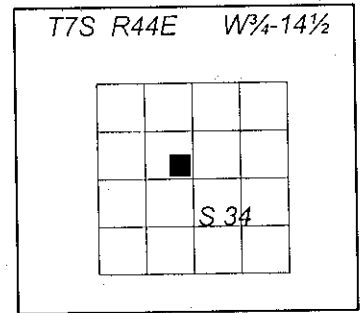


Description of corner evidence found:

Found a fir, 14 ins. diam., alive & healthy, with healed blaze on South face and low healed blazes on N., E., and W. faces.

From which

A 2½ ins. diam. steel post with a ¾ ins. diam. brass cap, mkd. as shown, firmly set, projecting 4 ins. above ground, with rock collar, bears S. 4° W., 8.85 ft. dist.

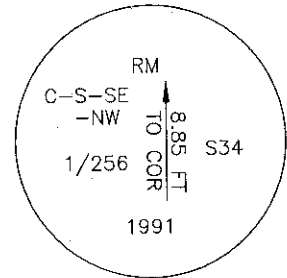

Description of monument and accessories I established to perpetuate original location of this corner:

New bearing tree

A Douglas fir, 16 ins. diam., bears N. 82° W., 29.1 ft. dist., mkd. 1/256 S34 BT, with washer in side center.

Set guard post 5 ft. from recovered monument with Land Survey Monument (54-9) sign.

CORS '02 geographic position:

Lat. 44°54'48.4" N
Long. 117°18'52.5" W

All bearing trees are painted with red bands, and have Bearing Tree (54-3) and Land Survey Monument (54-9) signs attached. All new bearing trees have a metal washer stamped "LS 2648" nailed in the side center.

Posted National Forest Boundary S. 89°43'50" W. and S. 6°51'20" W. from corner with Property Boundary (54-2) signs, and a Land Survey Monument (54-9) sign on nearby post.

Witnesses: Kristina Powell, Matt Brockamp and Nick Tressler

Date: August 18, 2009

REGISTERED
PROFESSIONAL
LAND SURVEYOR

OREGON
JANUARY 18, 1994
RON C. WALTER
2648

Renewal Date: June 30, 2010

Office of County Surveyor County of Baker
State of Oregon, I hereby certify that the within instrument was filed in this office
for record on the day of, 20
..... by
(COUNTY OFFICIAL) (DEPUTY)

FILED Feb. 24, 2010