

CERTIFIED RECORD OF LAND CORNER MONUMENTATION

History of original corner establishment:

Corner originally set by Barry B. Barbour, LS 1051, during survey filed with the Baker County Surveyor, file no. 7-44-78 said survey subsequently CANCELLED.

Record states:

At surveyed point set 2 1/2" x 30" aluminum pipe and cap, 26 ins. in the ground and mound of stone around to cap.

From which:

- A fir, 14 ins. diam., bears S. 68° E., 22.7 ft. dist., scribed WC C/E/NE/SW 1/256 S34 BT.
- A fir, 20 ins. diam., bears N. 86 1/2° W., 26.1 ft. dist., scribed WC C/E/NE/SW 1/256 S34 BT.

Both bearing trees have washers stamped PLS 1051.

Corner reestablished by Rick E. Tawney, et al, under Group No. 1554, approved April 21, 1992.


Record states:

Set a stainless steel post, 28 ins. long, 2 1/2 ins. diam., 10 ins. in the ground, to solid rock, and in a mound of stone, 3 ft. base to top, with brass cap.

From which the bearing trees mkd. by Barbour

- A fir, 14 ins. diam., bears S. 71° E., 33 lks. dist., with visible scribe on partially healed blaze.
- A fir, 25 ins. diam., bears N. 83 1/4° W., 40 1/2 lks. dist., with visible scribe on partially healed blaze.

Aluminum cap stamped by Barbour, PLS 1051, bears N. 4°00'00" W., 0.025 chs. dist.

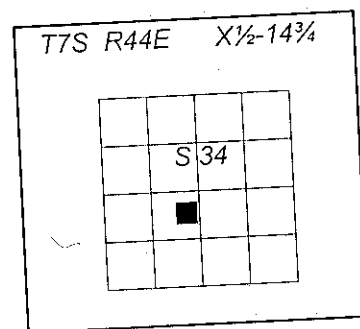


Description of corner evidence found:

Found a 2 1/2 ins. diam. steel post with a 3 1/4 ins. diam. brass cap, mkd. as shown, firmly set, projecting 3 ins. above ground, with rock collar.

From the recovered monument I find the bearing trees mkd. by Barbour

- A fir snag, 17 ins. diam., bears S. 71° E., 21.8 ft. dist., with visible scribe on open blaze.
- A Douglas fir, 27 ins. diam., alive & healthy, bears N. 83 1/4° W., 26.7 ft. dist., with visible scribe on open blaze.

Found guard post 5 ft. West of recovered monument with Land Survey Monument (54-9) sign.

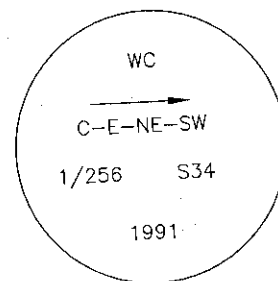

Description of monument and accessories I established to perpetuate original location of this corner:

New accessory

A chiseled X, in north-easterly face of large boulder outcrop, bears S. 7° W., 9.5 ft. dist.

Set guard post 5 ft. from recovered monument with Land Survey Monument (54-9) sign.

CORS '02 geographic position:

- Lat. 44°54'58.8" N
- Long. 117°18'50.9" W

All bearing trees are painted with red bands, and have Bearing Tree (54-3) and Land Survey Monument (54-9) signs attached.

Posted National Forest Boundary S. 89°18'37" W. and S. 6°48'00" W. from corner with Property Boundary (54-2) signs, and a Land Survey Monument (54-9) sign on nearby post.

Witnesses: Kristina Powell and Matt Brockamp

Date: August 26, 2009

REGISTERED
PROFESSIONAL
LAND SURVEYOR

Ron Walter

OREGON
JANUARY 18, 1994
RON C. WALTER
2648

Renewal Date: June 30, 2010

Office of _____ County Surveyor _____ County of Baker
State of Oregon _____, I hereby certify that the within instrument was filed in this office
for record on the _____ day of _____, 20 _____
_____ by _____ (DEPUTY)
(COUNTY OFFICIAL)

FILED Feb 24, 2010

BAKER COUNTY SURVEYOR

SURVEY NO. 7-44-248

Form R6-7100-57 (9/71)