

CERTIFIED RECORD OF LAND CORNER MONUMENTATION

History of original corner establishment:

Corner originally set by Barry B. Barbour, LS 1051, during survey filed with the Baker County Surveyor, file no. 7-44-78 said survey subsequently CANCELLED.

Record states:

At surveyed point set 2½" x 30" aluminum pipe and cap, 22 ins. in the ground and mound of stone around to cap.

From which:

A fir, 20 ins. diam., bears S. 41° E., 30.4 ft. dist., scribed CS 1/16 S34 BT.

A fir, 20 ins. diam., bears N. 20° W., 4.1 ft. dist., scribed CS 1/16 S34 BT.

Both bearing trees have washers stamped PLS 1051.

Corner reestablished by Rick E. Tawney, et al, under Group No. 1554, approved April 21, 1992.

Record states:


Set a stainless steel post, 28 ins. long, 2½ ins. diam., 8 ins. in the ground, to solid rock, and in a mound of stone, 3 ft. base to top, with brass cap.

From which the bearing trees mkd. by Barbour

A fir, 17 ins. diam., bears S. 36½° E., 41 lks. dist., with visible scribe on partially healed blaze.

A fir, 23 ins. diam., bears N. 50½° W., 11½ lks. dist., with visible scribe on partially healed blaze.

Aluminum cap stamped by Barbour, PLS 1051, bears N. 74°19'00" W., 0.060 chs. dist.

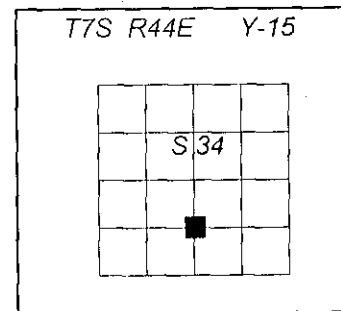

Description of corner evidence found:

Found a 2½ ins. diam. steel post with a 3¼ ins. diam. brass cap, mkd. as shown, firmly set, projecting 4 ins. above ground, with 3 ft. diam. stone mound.


From the recovered monument I find the bearing trees mkd. by Barbour

A fir snag, 17 ins. diam., bears S. 36½° E., 27.1 ft. dist., with visible scribe on open blaze.

A Douglas fir, 25 ins. diam., alive & healthy, bears N. 50½° W., 7.6 ft. dist., with healed blaze.

Found guard post 5 ft. East of recovered monument with Land Survey Monument (54-9) sign.

Found Barbour cap N. 74¼° W., 4.0 ft. from recovered monument.

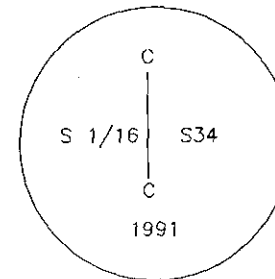

Description of monument and accessories I established to perpetuate original location of this corner:

New accessory

A chiseled X, in top of easterly face of large boulder outcrop, bears S. 40° W., 7.1 ft. dist.

Set guard post 5 ft. from recovered monument with Land Survey Monument (54-9) sign.

CORS '02 geographic position:

Lat. 44°54'32.4" N

Long. 117°18'46.5" W

All bearing trees are painted with red bands, and have Bearing Tree (54-3) and Land Survey Monument (54-9) signs attached.

Posted National Forest Boundary S. 88°57'57" W. and N. 89°10'19" E. from corner with Property Boundary (54-2) signs, and a Land Survey Monument (54-9) sign on nearby post.

Witnesses: Kristina Powell and Matt Brockamp

Date: August 26, 2009

REGISTERED
PROFESSIONAL
LAND SURVEYOR

Ron Walter

OREGON
JANUARY 18, 1994
RON C. WALTER
2648