

## CERTIFIED RECORD OF LAND CORNER MONUMENTATION

### **History of original corner establishment:**

Corner originally set by Barry B. Barbour, LS 1051, during survey filed with the Baker County Surveyor, file no. 7-44-78 said survey subsequently CANCELLED.

#### Record states:

At surveyed point set 2½" x 30" aluminum pipe and cap, 24 ins. in the ground and mound of stone around to cap.

#### From which:

A pine, 6 ins. diam., bears N. 35° E., 26.0 ft. dist., scribed C/W/W/E 1/256 S34 BT.  
A fir, 7 ins. diam., bears S. 14° E., 25.9 ft. dist., scribed C/W/W/E 1/256 S34 BT.

Both bearing trees have washers stamped PLS 1051.

Corner reestablished by Rick E. Tawney, et al, under Group No. 1554, approved April 21, 1992.

#### Record states:

Set a stainless steel post, 28 ins. long, 2½ ins. diam., 21 ins. in the ground, and in a collar of stone, with brass cap.

#### From which bearing trees mkd. by Barbour

A pine, 6 ins. diam., bears N. 27¾° E., 37½ lks. dist., with visible marks on partially healed blaze.  
A pine, 8 ins. diam., bears S. 7° E., 37½ lks. dist., with visible marks on partially healed blaze.

Aluminum cap stamped by Barbour, PLS 1051, bears N. 75°50'00" W., 0.045 chs. dist.

### **Description of corner evidence found:**

Found a 2½ ins. diam. steel pipe with a ¾ ins. diam. brass cap, mkd. as shown, cap is mis-marked, firmly set, projecting 2 ins. above ground with a rock collar.

From the recovered monument I find the bearing trees mkd. by Barbour

A pine, 6 ins. diam., dead & down, bears N. 27¾° E., 24.8 ft. dist., with visible scribe on open blaze.  
A pine, 11 ins. diam., alive & healthy, bears S. 7° E., 24.8 ft. dist., with visible scribe on open blaze.

Found guard post 5 ft. South of recovered monument with Land Survey Monument (54-9) sign.

Found Barbour cap N. 76° W., 3.0 ft. from recovered monument.

### **Description of monument and accessories I established to perpetuate original location of this corner:**

#### New accessory

A chiseled XBO, in southerly face of 7' x 5' x 4' boulder rock outcrop, bears N. 18° E., 13.9 ft. dist.

#### CORS '02 geographic position:



Lat. 44°54'45.5" N  
Long. 117°18'39.6" W

All bearing trees are painted with red bands, and have Bearing Tree (54-3) and Land Survey Monument (54-9) signs attached.

Posted National Forest Boundary S. 89°22'33" W. and S. 6°25'37" W. from corner with Property Boundary (54-2) signs, and a Land Survey Monument (54-9) sign on nearby post.

Witnesses: Kristina Powell, Matt Brockamp and Nick Tressler.

Date: August 18, 2009

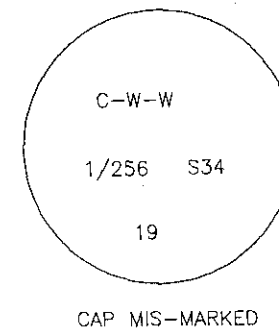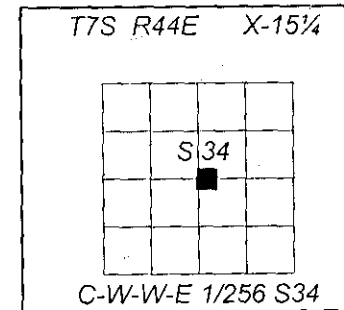

REGISTERED  
PROFESSIONAL  
LAND SURVEYOR

*Ron Walter*