

CERTIFIED RECORD OF LAND CORNER MONUMENTATION

History of original corner establishment:

Original corner set by Barry B. Barbour, LS 1051, during survey filed with the Baker County Surveyor, file No. 7-44-75, said survey subsequently CANCELLED.

Record states:

At surveyed point set 2½" x 30" aluminum pipe and cap, set pipe 18" in the ground. No rock in the area.

From which:

A fir, 6 ins. diam., bears S. 55° E., 28.2 ft. dist., scribed N1/16 S33 BT.

A fir, 8 ins. diam., bears N. 70° W., 9.5 ft. dist., scribed N1/16 S32 BT.

Both bearing trees have brass washers stamped PLS 1051.

Corner reestablished by Rick E. Tawney, et al, under Group No. 1554, approved April 21, 1992.

Record states


Set a stainless steel post, 28 ins. long, 2½ ins. diam., 24 ins. in the ground, with brass cap.

From which

A pine, 11 ins. diam., bears S. 81¼° E., 45½ lks. dist., mkd. N 1/16 S33 BT.

A fir, 10 ins. diam., bears N. 28° W., 51½ lks. dist., mkd. N 1/16 S32 BT.

Aluminum cap stamped by Barbour, PLS 1051, bears N. 87°21'00" E., 3.210 chs. dist. I bury this monument in place and obliterate the marks on the bearing trees.

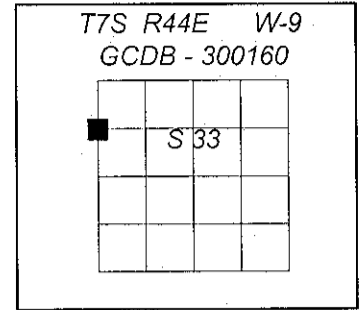

Description of corner evidence found:


Found a 2½ ins. diam. steel pipe with a 3¼ ins. diam. brass cap, firmly set, flush with ground, in rock collar, mkd. as shown,

From the recovered monument I find the bearing trees mkd. by Tawney

A pine snag, 18 ins. diam., bears S. 81¼° E., 30.0 ft. dist., with healed blaze.

A fir, 17 ins. diam., alive and healthy, bears N. 28° W., 34.0 ft. dist., with healed blaze.

Found guard post 5 ft. East with Land Survey Monument (54-9) and Property Boundary (54-2) signs.

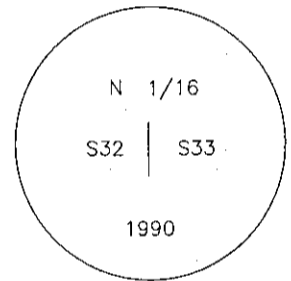

Description of monument and accessories I established to perpetuate original location of this corner:

New bearing tree

A pine, 16 ins. diam., bears S. 74° E., 43.9 ft. dist., mkd. N 1/16 S 33 BT, with washer on side center.

CORS '02 geographic position:

Lat. 44°54'58.2" N
Long. 117°20'27.6" W

All bearing trees are painted with red bands, and have Bearing Tree (54-3) and Land Survey Monument (54-9) signs attached. All new bearing trees have a metal washer stamped "LS 2648" nailed in the side center.

Posted National Forest Boundary S. 89°55'29" E. and S. 09°05'57" W. from corner with Property Boundary (54-2) signs, and a Land Survey Monument (54-9) sign on nearby post.

Witnesses: Kristina Powell and Matt Brockamp

Date: July 22, 2009

REGISTERED
PROFESSIONAL
LAND SURVEYOR

Ron Walter

OREGON
JANUARY 18, 1994
RON C. WALTER
2648

Renewal Date: June 30, 2010

Office of County Surveyor County of Baker
State of Oregon , I hereby certify that the within instrument was filed in this office
for record on the day of , 20
..... by
(COUNTY OFFICIAL) (DEPUTY)

FILED Feb. 24, 2010