

CERTIFIED RECORD OF LAND CORNER MONUMENTATION

History of original corner establishment:

Original Corner established by Barry B. Barbour, LS 1051, during survey filed with the Baker County Surveyor, file No. 7-44-78, said survey subsequently CANCELLED.

Record states:

At surveyed point set 2½" x 30" aluminum pipe and cap, set pipe 24" in the ground, with mound of stone to top..

From which:

A fir, 10 ins. diam., bears S. 88° E., 35.8 ft. dist., scribed C1/4 S33 BT.

A pine, 12 ins. diam., bears N. 35° W., 43.5 ft. dist., scribed C1/4 S33 BT.

Both bearing trees have brash washers stamped PLS 1051.

Corner reestablished by Rick E. Tawney, et al, under Group No. 1554, approved April 21, 1992.

Record states


Set a stainless steel post, 28 ins. long, 2½ ins. diam., 16 ins. in the ground, to solid rock, and in a mound of stone, 2 ft. base, to top, with brass cap.

From which bearing trees mkd. by Barbour

A fir, 11 ins. diam., bears S. 71¾° E., 54½ lks. dist., scribe mks. C1/4 S33 BT visible on partially healed double blaze.

A pine, 14 ins. diam., bears N. 45¾° W., 55½ lks. dist., scribe mks. C1/4 S33 BT visible on partially healed double blaze.

Aluminum cap stamped by Barbour, PLS 1051, bears S. 8°11'00" W., 0.155 chs. dist. I bury this monument in place.

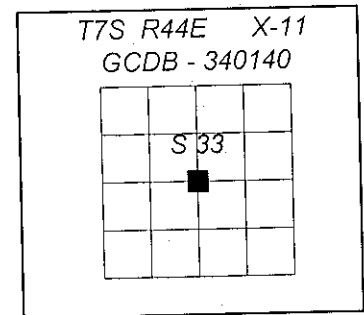


Description of corner evidence found:

Found a 2½ ins. diam. steel pipe with a 3¼ ins. diam. brass cap, firmly set, projecting 2 ins. above ground, in rock collar, mkd. as shown,

From the recovered monument I find the bearing trees mkd. by Barbour

A fir, 15 ins. diam., alive and healthy, bears S. 71¾° E., 36.0 ft. dist., with healed blaze.

A pine, 18 ins. diam., alive and healthy, bears N. 45¾° W., 36.6 ft. dist., with healed blaze.

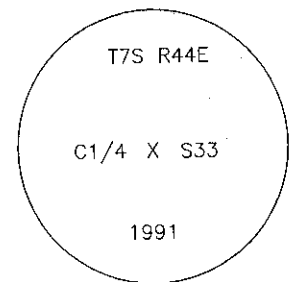

Description of monument and accessories I established to perpetuate original location of this corner:

New bearing trees

A pine, 20 ins. diam., bears N. 68° E., 5.6 ft. dist., mkd. C1/4 S33 BT.

A pine, 6 ins. diam., bears S. 64° W., 80.1 ft. dist., mkd. X BT, on double blaze.

CORS '02 geographic position:

Lat. 44°54'45.0" N
Long. 117°19'54.5" W

All bearing trees are painted with red bands, and have Bearing Tree (54-3) and Land Survey Monument (54-9) signs attached. All new bearing trees have a metal washer stamped "LS 2648" nailed in the side center.

Posted National Forest Boundary S. 09°07'57" W. and N. 09°07'16" E. from corner with Property Boundary (54-2) signs, and a Land Survey Monument (54-9) sign on nearby post.

Witnesses: Kristina Powell and Matt Brockamp

Date: July 22, 2009

REGISTERED
PROFESSIONAL
LAND SURVEYOR

Ron Walter

OREGON
JANUARY 18, 1994
RON C. WALTER
2648

Renewal Date: June 30, 2010

Office of County Surveyor County of Baker
State of Oregon , I hereby certify that the within instrument was filed in this office
for record on the day of , 20
..... by
(COUNTY OFFICIAL) (DEPUTY)

FILED Feb. 24, 2010