


**CERTIFIED RECORD OF LAND CORNER MONUMENTATION**

History of original corner establishment:

Corner was originally established in 1982 by Barry B. Barbour, LS 1051, under contract for the Wallowa-Whitman National Forest as shown on Record Survey No. 7-44-73. Also see certified record of land corner no. (LCR) 7-44-93.

index no. H-6

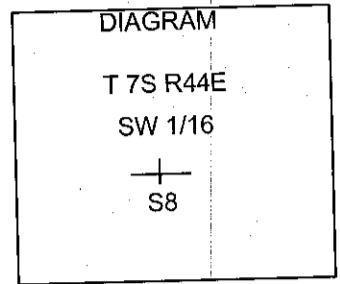

Description of corner evidence found:

Found 2-1/2" diameter brass cap on 2" iron post projecting 4" from the ground and stamped as shown:

From Which:


A Dead Fir, 14" diam. bears N 18°E, 13.2 feet dist. with visible scribing in open blaze.

A White Fir, 18" diam. bears S 50°W, 25.6 feet dist. with healed over blaze.

Corner is witnessed with 6' steel fence post 5' South and 5' West. Post have USFS boundary signs and survey monument signs attached.

Placed new bearing tree tag and brass washer stamped "G WAGNER" LS 02817 on face of BT blaze. Painted blazes red and 6" red band around tree above BT Tag on all bearing trees.

stamping:

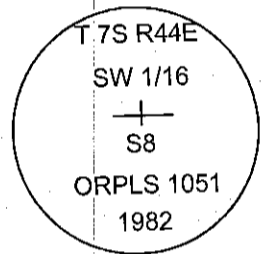

Description of monument and accessories I established to perpetuate the original location of this corner:

From Which: (by magnetic declination of 20°East)

New Bearing Tree:

A White Fir, 9" diam. bears N 12°E, 29.8 feet dist. mkd. SW 1/16 S8 BT

Placed new bearing tree tag and brass washer stamped "G WAGNER" LS 02817 on face of BT blaze. Painted blazes red and 6" red band around tree above BT Tag on all bearing trees.



RENEWS 6/30/12

Office of County Surveyor, County of Baker  
State of Oregon, I hereby certify that the within instrument was filed in this office  
for record on the \_\_\_\_\_ day of \_\_\_\_\_ 2010

FILED Oct. 4, 2010  
BAKER COUNTY SURVEYOR  
SURVEY NO. 7-44-259