


CERTIFIED RECORD OF LAND CORNER MONUMENTATION

History of original corner establishment:

Original corner was established by GLO Surveyor William B. Barr, under contract no. 503 dated May 23, 1884.

index no. J-5

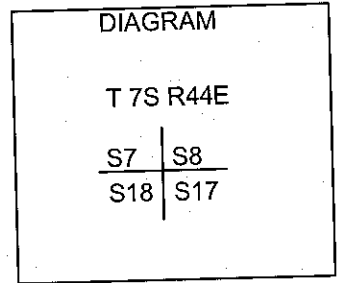

1974 Remonumentation:

The original corner and one standing bearing tree was found in 1974 by BLM Cadastral Surveyor Lester E. Fischer as described on pages 35 & 36 of Field Notes of the Remonumentation of certain original corner points of Township 7 South, Range 44 East (see Volume OR-R0600 Pages 0163-0164)

Set 2-1/2" iron post, 28" long, 24" in the ground with 2-1/2" brass cap attached.

From Which:

- A Douglas Fir, 26" diam. bears N 45°W, 23 lks. (15.2') dist. with healed blaze (original b.t.)
- A Fir, 8" diam. bears N 35°E, 53 lks. (35.0') dist. mkd. T7S R44E S8 BT
- A White Fir, 8" diam. bears S 23°E, 29.5 lks. (19.5') mkd. T7S R44E S17 BT
- A White Fir, 9" diam. bears S 49°W, 17 lks. (11.1') dist. mkd. T7S R44E S18 BT


Description of corner evidence found:

Found 2-1/2" diameter B.L.M. brass cap on 2" iron post at base of dead snag. Monument was loose in the ground and lying 45° from vertical to the north. Also found original basalt stone 10"x12"x6" lying loose, approx. 3' to the north. Straightened monument to vertical and placed original stone alongside.

From Which: (by magnetic declination of 20° East)

- A Douglas Fir, 31" diam. bears N 45°W, 14.6 feet dist. with healed over blaze. (original b.t.)
- A Douglas Fir, 18" diam. bears N 35°E, 35.3 feet dist. with healed over blaze.
- A Douglas Fir, 16" diam. bears S 23°E, 19.7 feet dist. with healed over blaze.
- A Douglas Fir, 12" diam. bears S 49°W, 11.1 feet dist. with healed over blaze.

stamping:

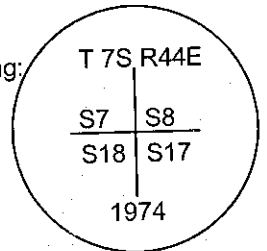

Corner is witnessed with 6' steel fence post 5' west and 5' south. Post have USFS boundary signs and survey monument signs attached.

Placed new bearing tree tags and brass washers stamped "G WAGNER" LS 02817 on face of all BT blazes. Painted blazes red and painted 6" red bands around trees above BT Tags.

Description of monument and accessories I established to perpetuate the original location of this corner:

REGISTERED
PROFESSIONAL
LAND SURVEYOR

Gary B. Wagner

OREGON
JUNE 30, 1997
GARY B. WAGNER
02817LS

RENEWS 6/30/12

Office of County Surveyor, County of Baker
State of Oregon, I hereby certify that the within instrument was filed in this office
for record on the _____ day of _____ 2010

FILED Oct. 4, 2010
BAKER COUNTY SURVEYOR
SURVEY NO. 7-44-261