


CERTIFIED RECORD OF LAND CORNER MONUMENTATION

History of original corner establishment:

Corner established by W. B. Barr under Contract No. 443, dated May 29, 1882.

Surveyor's General record states:


Set a granite boulder 9 ins. x 9 ins. x 8 ins., 6 inches in the ground for 1/4 Section corner marked 1/4 on West side and raised mound of rock alongside. Pits impractical.

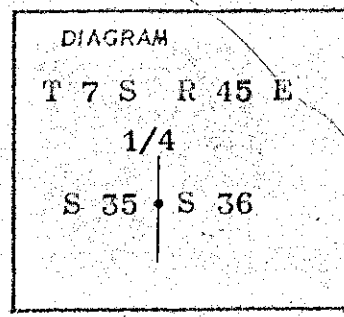

Description of corner evidence found: -

Description of monument and accessories I established to perpetuate the original location of this corner

Set 2 inch aluminum cap on 1 inch iron post, 28 inches long, 22 inches in the ground, marked thus:

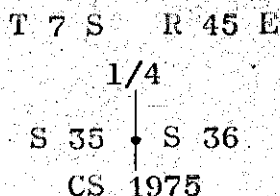

New bearing trees:

- A pine, 15 ins. in diam., bears N. 27° W., 43.6 ft. dist., marked 1/4 S 35 BT.
- A pine, 13 ins. in diam., bears N. 39° E., 34.9 ft. dist., marked 1/4 S 36 BT.

Office of..... County Surveyor..... County of..... Baker.....
State of..... Oregon....., I hereby certify that the within Instrument was filed in this office for record on the day of

..... by
(COUNTY OFFICIAL) (DEPUTY)

FILED 3-2-76
BAKER COUNTY SURVEYOR
SURVEY NO. 7-45-4

