


CERTIFIED RECORD OF LAND CORNER MONUMENTATION

Index File No. N-15

History of original corner establishment:

Corner established August 4, 1882, by W. B. Barr, under G.L.O. Contract No. 443. Surveyor General's notes state:

"A Pine 5" in diam. which I mark 1/4S on the north side, from which: A Fir 28" in diam. bears N82°E, 43 lks dist. marked 1/4S BT. A Pine 3" in diam bears S70°E, 38 lks dist. marked 1/4S BT."

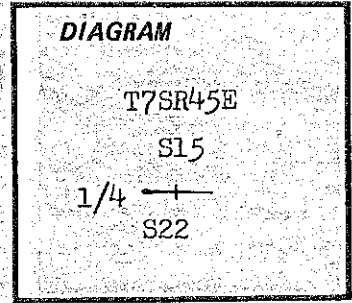

Description of corner evidence found:

Found no trace of corner tree or bearing trees. Area has been badly burned and only a few charred stumps exist in the area.

Corner is south of a small ridge and 60' west of an old track road.

Description of monument and accessories established to perpetuate the original location of this corner:

At surveyed point set 2 1/2" x 30" galvanized pipe with brass cap marked: Set pipe 24" in the ground and mound of stone around to cap.

T7SR45E  
S15  
1/4 ———  
S22  
OR PLS 1051  
1978

From which: A Pine 15" in diam. bears S85°W, 142.9 ft. scribed 1/4 S22 BT. A Pine 12" in diam. bears N32°W, 49.9 ft. scribed 1/4 S15 BT. Painted blazes red and 6" red band around. Placed 54-3s & 54-4s on BTs. Placed brass washer stamped PLS 1051 on foot blazes. Placed 54-2 on steel fence post 3' west and 54-2 & 54-4 on steel fence post 4' south of corner. Placed 54-5 on small tree east of road, 75' SE of corner.

REGISTERED PROFESSIONAL LAND SURVEYOR

*Barry B. Barbour*

OREGON OCT. 17, 1975 BARRY B. BARBOUR 1051

I hereby certify the above corner monument was reestablished as herein described.

Witnesses: David L. Landers Jim McFarland

July 28, 1978

Office of... County Surveyor... County of... Baker  
State of... Oregon... I hereby certify that the within instrument was filed in this office for record on the 25... day of... August... 1978.

..... by .....  
(COUNTY OFFICIAL) (DEPUTY)

Form R6-7100-57 (9/71)

GPO 799-509

FILED Aug 25, 1978  
BAKER COUNTY SURVEYOR  
SURVEY NO. 7-45-8