


CERTIFIED RECORD OF LAND CORNER MONUMENTATION

Index File No. J-21

History of original corner establishment:

Corner established July 29, 1882, by W. B. Barr, under G.L.O. Contract No. 443. Surveyor General's notes state:

"Set Basalt rock 17"x11"x9" 12" in the ground for corner to Sec. 11, 12, 13, 14, marked with 1 notch on the East and 4 notches on the South edges from which, a Pine 28" in diam. bears N20°E, 96 lks dist. marked T7SR45E S12 BT. A Pine 28" in diam. bears N20°W, 90 lks dist. marked T7SR45E S11 BT. A Pine 24" in diam. bears S36°W, 58 lks dist. marked T7SR45E S14 BT. A Pine 14" in diam. bears S31°E, 70 lks dist. marked T7SR45E S13 BT."

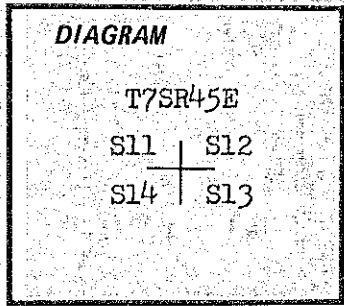

Description of corner evidence found:

Found no trace of corner stone as position falls in skid road.

Measured S20°W, 63.4 ft. from 36" Pine scribed T7S 12. NW BT down with some visible scribing. Skid road above and no stump hole. SE and SW BTs down and disturbed by logging.

Corner is about 50' NW of Dixie Creek drain and 1000' above road S720B.

Description of monument and accessories established to perpetuate the original location of this corner:

At measured point set 2 1/2" x 30" galvanized pipe with brass cap marked: Set pipe 18" in the ground to bedrock and mound of stone around to cap.

T7SR45E
S11 | S12
S14 | S13
OR PLS 1051
1978

From which: A Fir 11" in diam. bears S69 1/2°E, 23.9 ft. scribed T7SR45E S13 BT. A Pine 14" in diam. bears S34°W, 68.4 ft. scribed T7SR45E S14 BT. A Pine 24" in diam. bears N89°W, 97.8 ft. scribed T7SR45E S11 BT. Painted blazes red and 6" red band around. Placed 54-3 & 54-4s on BTs. Old NE BT has 54-3, 54-4, & 54-5. Placed brass washer stamped PLS 1051 on foot blazes. Placed 54-4 on steel fence post 5' west of corner. Placed 54-5 on small tree 25' north of corner. Placed 54-5 on road S720B where it crosses Dixie Creek about 1000' SW from corner.

I hereby certify the above corner monument was reestablished as herein described.

Witness: David L. Landers

July 6, 1978

REGISTERED PROFESSIONAL LAND SURVEYOR

Barry B. Barbour

OREGON OCT. 17, 1975 BARRY B. BARBOUR 1051

Office of... County Surveyor Baker
State of... Oregon
I hereby certify that the within instrument was filed in this office for record on the 25 day of August 1978
by
(COUNTY OFFICIAL) (DEPUTY)

Form R6-7100-57 (9/71)

☆ GPO 799-509

FILED Aug. 25, 1978

BAKER COUNTY SURVEYOR

SURVEY NO. 7-45-9