


CERTIFIED RECORD OF LAND CORNER MONUMENTATION

Index File No. J-13

History of original corner establishment:

Corner established August 5, 1882, by W. B. Barr, under G.L.O. Contract No. 443. Surveyor General's notes state:

"Set Basalt rock 12"x12"x6" 8" in the ground for corner to Sec. 9, 10, 15, 16, marked with 3 notches on the East and 4 notches on the South edges from which: A Fir 5" in diam. bears N70°E, 18 lks dist. marked T7SR45E S10 BT. A Fir 26" in diam. bears N68°W, 30 lks dist. marked T7SR45E S9 BT. A Fir 22" in diam. bears S36°W, 14 lks dist. marked T7SR45E S16 BT. A Fir 5" in diam. bears S70°E, 18 lks dist. marked T7SR45E S15 BT."

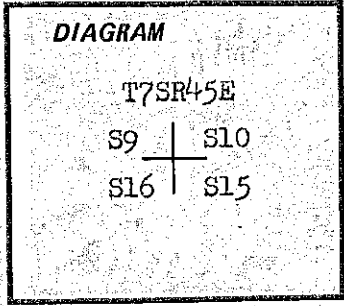


Description of corner evidence found:

No trace of corner stone or bearing trees could be found. Area has not been logged.

Corner falls about 65' north of main ridge, which fits Topo. call.

Description of monument and accessories established to perpetuate the original location of this corner:

At surveyed point set 2 1/2" x 30" galvanized pipe with brass cap marked: Set pipe 15" in the ground to bedrock and mound of stone to cap.

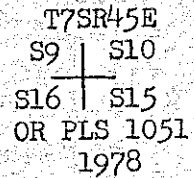

From which: A Pine 12" in diam. bears N72°E, 36.8 ft. scribed T7SR45E S10 BT. A Fir 14" in diam. bears S23 1/2°E, 83.8 ft. scribed T7SR45E S15 BT. A Fir 18" in diam. bears S09°W, 37.5 ft. scribed T7SR45E S16 BT. A Fir 9" in diam. bears N32°W, 37.5 ft. scribed T7SR45E S9 BT. Painted blazes red and 6" red band around. Placed 54-3s & 54-4s on BTs. Placed brass washer stamped PLS 1051 on foot blazes. Placed 54-4 on steel fence post 6' west of corner. Placed 54-5 on SW BT.

REGISTERED PROFESSIONAL LAND SURVEYOR

*Barry B. Barbour*

OREGON OCT. 17, 1975 BARRY B. BARBOUR 1051

I hereby certify the above corner monument was reestablished as herein described.

Witnesses: David L. Landers Jim McFarland

August 3, 1978

Office of...County...Surveyor..... County of... Baker State of Oregon..... I hereby certify that the within instrument was filed in this office for record on the 25 day of August, 1978.

(COUNTY OFFICIAL)

(DEPUTY)

Form R6-7100-57 (9/71)

☆ GPO 799-509

FILED Aug. 25, 1978

BAKER COUNTY SURVEYOR

SURVEY NO. 7-45-10