


CERTIFIED RECORD OF LAND CORNER MONUMENTATION

Index File No. J-17

History of original corner establishment:

Corner established August 2, 1882, by W. B. Barr, under G.L.O. Contract No. 443. Surveyor General's notes state:

"Set Basalt rock 24"x14"x10" 18" in the ground for corner to Sec. 10, 11, 14, 15, marked with 4 notches on the south and 2 notches on the east edges from which: A Maple 4" in diam. bears N75°E, 40 lks dist. marked T7SR45E S11 BT. An Alder 3" in diam. bears N60°W, 20 lks dist. marked T7SR45E S10 BT. A Maple 6" in diam. bears S68°W, 13 lks dist. marked T7SR45E S15 BT. A Willow 6" in diam. bears S45°E, 20 lks dist. marked T7SR45E S14 BT."

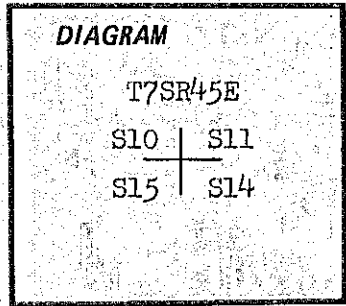


Description of corner evidence found:

No trace of corner or BTs could be found. A definite area for searching could be determined by drain calls. Several large Firs nearby could have been used for BTs instead of the short lived types called for in the notes. Road construction above the search area resulted in many large rocks being in the area.

Corner falls about 200' north of Tunnel Creek near a small branch.

Description of monument and accessories established to perpetuate the original location of this corner:

At surveyed point set 2 1/2" x 30" galvanized pipe with brass cap marked: Set pipe 24" in the ground and mound of stone around to cap.

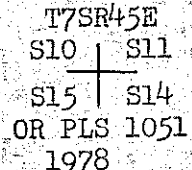

From which: A Pine 24" in diam. bears N82°E, 37.8 ft. scribed T7SR45E S11 BT. A Pine 14" in diam. bears S53°E, 36.0 ft. scribed T7SR45E S14 BT. A Pine 10" in diam. bears S63°W, 97.6 ft. scribed T7SR45E S15 BT. A Pine 9" in diam. bears N70 1/2°W, 76.2 ft. scribed T7SR45E S10 BT. Painted both blazes red and 6" red band around. Placed 54-3s & 54-4s on BTs. Placed brass washer stamped PLS 1051 on foot blazes. Placed 54-4 on steel fence post 3' north of corner. Placed 54-5 on large Fir 40' east of corner.

I hereby certify the above corner monument was reestablished as herein described,

Witnesses: David L. Landers Dan T. Rowland

August 8, 1978

REGISTERED PROFESSIONAL LAND SURVEYOR

Barry B. Barbour

OREGON OCT. 17, 1975 BARRY B. BARBOUR 1051

Office of... County Surveyor... County of... Baker Oregon... I hereby certify that the within instrument was filed in this office for record on the... 25... day of August... 1978

(COUNTY OFFICIAL)

(DEPUTY)

Form R6-7100-57 (9/71)

☆ GPO 799-509

FILED Aug. 25, 1978 BAKER COUNTY SURVEYOR SURVEY NO. 7-45-11