


CERTIFIED RECORD OF LAND CORNER MONUMENTATION

Index File No. L-15

History of original corner establishment:

Not set.

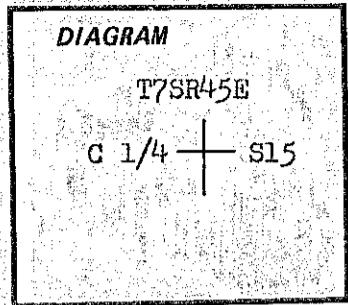

Description of corner evidence found:

None.

Corner falls on steep east slope.

Description of monument and accessories established to perpetuate the original location of this corner:

At surveyed point set 2 1/2" x 30" galvanized pipe with brass cap marked:
Set pipe 25" in the ground and mound of stone around to cap.

T7SR45E

C 1/4 + S15

OR PLS 1051

1978

From which: A Pine 10" in diam. bears N57°E, 46.5 ft. scribed.
C 1/4 S15 BT. A Pine 8" in diam. bears S17°E, 44.4 ft. scribed.
C 1/4 S15 BT. Painted blazes red and 6" red band around. Placed
54-3s & 54-4s on BTs. Placed brass washer stamped PLS 1051 on foot
blazes. Placed 54-2, 54-4, & 54-9 on steel fence post 3' south of corner.
Placed 54-5 on tree 15' north of corner.

REGISTERED
PROFESSIONAL
LAND SURVEYOR

Barry B. Barbour

OREGON
OCT. 17, 1975
BARRY B. BARBOUR
1051

I hereby certify the above corner monument was reestablished as herein described.

Witnesses: David L. Landers
Dan T. Rowland

August 10, 1978

Office of County Surveyor County of Baker
State of Oregon I hereby certify that the within instrument was filed in this office
for record on the 25 day of August, 1978

(COUNTY OFFICIAL)

(DEPUTY)

Form R6-7100-57 (9/71)

☆ GPO 799-509

FILED Aug. 25, 1978

BAKER COUNTY SURVEYOR

SURVEY NO. 7-45-15