


CERTIFIED RECORD OF LAND CORNER MONUMENTATION

Index File No. L-16

History of original corner establishment:

Not set.

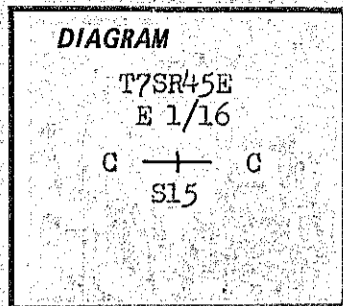

Description of corner evidence found:

None.

Corner is the west side of Pine Creek, 25' south of a private road.

Description of monument and accessories established to perpetuate the original location of this corner:

At surveyed point set 2 1/2" x 30" galvanized pipe with brass cap marked:
Set pipe 24" in the ground and mound of stone around to cap.

From which: A Fir 12" in diam. bears S50°W, 7.8 ft. scribed ECL/16 S15 BT. A Fir 18" in diam. bears N36 1/2°W, 32.8 ft. scribed ECL/16 S15 BT. Painted blazes red and 6" red band around. Placed 54-3s & 54-4s on BTs. Placed brass washer stamped PLS 1051 on foot blazes. Placed 54-2 & 54-4 on steel fence post 3' north and 54-2 & 54-9 on steel fence post 5' east of corner. Placed 54-5 on tree 10' south of corner.

T7SR45E
E 1/16
C —+— C
S15
OR PLS 1051
1978

I hereby certify the above corner monument was reestablished as herein described.

Witnesses: David L. Landers
Dan T. Rowland

August 10, 1978

REGISTERED
PROFESSIONAL
LAND SURVEYOR

Barry B. Barbour

OREGON
OCT. 17, 1975
BARRY B. BARBOUR
1051

Office of County Surveyor County of Baker
State of Oregon I hereby certify that the within instrument was filed in this office
for record on the 25 day of August, 1978
..... by

(COUNTY OFFICIAL)

(DEPUTY)

Form R6-7100-57 (9/71)

GPO 799-509

FILED Aug. 25, 1978
BAKER COUNTY SURVEYOR
SURVEY NO. 7-45-16