

CERTIFIED RECORD OF LAND CORNER MONUMENTATION

Index File No. K-16

History of original corner establishment:

Not set.

DIAGRAM

T7SR45E

WWCNE

1/16 S15

Description of corner evidence found:

None.

Corner is on flat east of road, 4' west of bank and 15' west of edge of water.

Description of monument and accessories I established to perpetuate the original location of this corner:

At surveyed point set $2\frac{1}{2}$ " x 30" galvanized pipe with brass cap marked:


Set pipe 25" in the ground and mound of stone around to cap.

From which: A Fir 18" in diam. bears N02°E, 28.0 ft. scribed
WWCNE 1/16 S15 BT. The south witness corner bears S100° 35' 33"E,
180.56 ft. Painted blazes red and 6" red band around BT. Placed
brass washer stamped PLS 1051 on foot blaze. Placed 54-3 & 54-4 on BT.
Placed 54-2, 54-4, & 54-9 on steel fence post 3' east of corner. Placed
54-5 on west side of BT.T7SR45E
WWCNE | WEST
1/16 S15 | 32.4 FT.
OR PLS 1051
1978

I hereby certify the above corner monument was reestablished as herein described.

Witnesses: David L. Landers
Dan T. Rowland

August 11, 1978

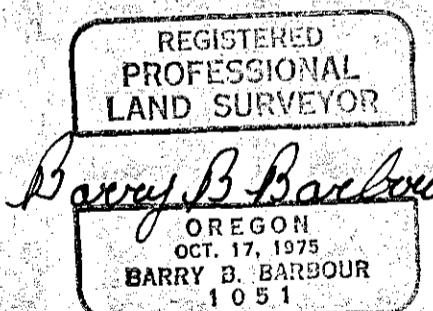

Office of County Surveyor County of Baker

State of Oregon I hereby certify that the within instrument was filed in this office
for record on the 25 day of August 1978..... by
(COUNTY OFFICIAL) (DEPUTY)

Form R6-7100-57 (9/71)

* GPO 799-509

FILED AUG. 25, 1978

BAKER COUNTY SURVEYOR
SURVEY NO. 7-45-18