


CERTIFIED RECORD OF LAND CORNER MONUMENTATION

History of original corner establishment:

Corner was established in 1882 by W.B. Barr under General Land Office Contract No. 443.
 Surveyor General's records state:
 Set iron rock 15 x 10 x 6 in. 10" in ground for $\frac{1}{4}$ sec. corner mkd. $\frac{1}{4}$ on the N side, from which:
 A pine 35" dia. bears N 56 W, 14 lks. dist. mkd. $\frac{1}{4}$ S BT.
 A fir 4" dia. bears S 15 W, 130 lks. dist. mkd. $\frac{1}{4}$ S BT.

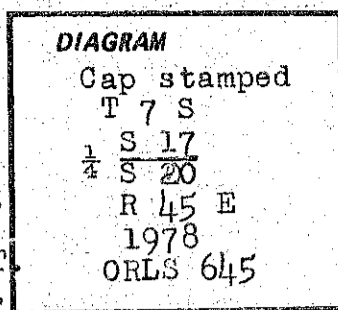

Description of corner evidence found:

At assumed corner location I found an iron rock 15 x 10 x 6 in. in 10" in ground and mkd. $\frac{1}{4}$ on N face from which a badly rotted pine approx. 28" dia. bears N 56 W, 14 lks. dist. - could not find evidence of any scribing.
 A portion of a rotted stump and hole bears S 15 W, 130 lks. dist.

Description of monument and accessories established to perpetuate the original location of this corner:

I set a 2 $\frac{1}{2}$ " x 30" galv. iron pipe w/brass cap stamped as shown above and placed 15 x 10 x 6 in. stone upside down in hole along side monument and buried both in a large mound of stone and dirt.

New bearing trees:

9" fir bears N 31 W, 73.67 ft. scribed $\frac{1}{4}$ S S 17 BT.
 8" fir bears S 05 E, 82.50 ft. scribed $\frac{1}{4}$ S S 20 BT.

I hereby certify the above corner monument was re-established as herein described in August 1978.

Witnesses: Leonard E. Breen Crew Chief
L. D. Shirley Instrument Man

REGISTERED
PROFESSIONAL
LAND SURVEYOR

James H. Hambleton
8-21-78

OREGON
JULY 10, 1964
JAMES H. HAMBLETON
645

Office of..... County of.....
 State of..... I hereby certify that the within instrument was filed in this office
 for record on the..... day of....., 19.....
 by
 (COUNTY OFFICIAL) (DEPUTY)

Form R6-7100-57 (9/71)

☆ GPO--798-276

FILED 9-26-78
 BAKER COUNTY SURVEYOR
 SURVEY NO. 7-45-20