


CERTIFIED RECORD OF LAND CORNER MONUMENTATION

②

History of original corner establishment:

Corner was established in 1882 by W.B. Barr under General Land Office Contract No. 443. Surveyor General's records state: Set post 4 ft. long 4" dia. 24" in ground for corner to sec's. 16, 17, 20 & 21, marked T 7 S S 16 on the NE side, R 45 E S 21 on SE side, S 20 on the SW side and S 17 on the NW side with 3 notches on S and 4 notches on the E edges from which:

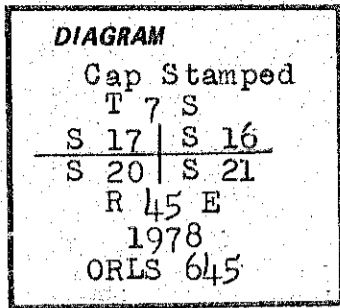

- An alder 4" dia. bears N 33", 38 lks. dist. mkd. T 7 S R 45 E S 16 BT.
- An alder 4" dia. bears S 75 E, 40 lks. dist. mkd. T 7 S R 45 E S 21 BT.
- An alder 3" dia. bears S 12 W, 28 lks. dist. mkd. T 7 S R 45 E S 20 BT.
- An alder 3" dia. bears N 06 W, 23 lks. dist. mkd. T 7 S R 45 E S 17 BT.

Description of corner evidence found:

At assumed corner location I found no trace of the original corner or the bearing trees though the GLO notes also mention calls to the creek and a spring brance, thus I determined this corner to be obliterated and with the collateral evidence of the creek and spring brance, using the GLO call, I restored the corner as nearly as possible to its original location.

Description of monument and accessories I established to perpetuate the original location of this corner:

I set a 2 1/2" x 30" galv. iron pipe w/brass cap stamped as shown above in the ground in mound of stone.

New bearing trees:

- 11" fir bears N 56 E, 78.63 ft. scribed T 7 S R 45 E S 16 BT.
- 6" fir bears S 04 E, 54.42 ft. scribed T 7 S R 45 E S 21 BT.
- 18" fir bears S 64 E, 99.29 ft. scribed T 7 S R 45 E S 20 BT.
- 5" pine bears N 02 W, 86.52 ft. scribed T 7 S R 45 E S 17 BT.

REGISTERED  
PROFESSIONAL  
LAND SURVEYOR

*James H. Hambleton*  
8-21-78

OREGON  
JULY 10, 1964  
JAMES H. HAMBLETON  
645

I hereby certify the above corner Monument was re-established as herein described in August 1978.

Witnesses: *Leonard E. Thorne*  
Crew Chief  
*S. D. Shirley*  
Instrument Man

Office of..... County of.....  
State of..... I hereby certify that the within instrument was filed in this office  
for record on the..... day of....., 19.....  
..... by.....  
(COUNTY OFFICER) (DEPUTY)

FILED 9-26-78  
BAKER COUNTY SURVEYOR  
SURVEY NO. 7-45-21