


CERTIFIED RECORD OF LAND CORNER MONUMENTATION

History of original corner establishment:

Corner was established in 1882 by W.B. Barr under General Land Office Contract No. 443. Surveyor General's records state: Set volcanic rock 16 x 8 x 6 in. 11" in ground for 1/4 sec. corner, mkd. 1/4 on N side from which: A fir 7" dia. bears S 45 W, 50 lks. dist. mkd. 1/4 S BT. A fir 28" dia. bears N 21 W, 14 lks. dist. mkd. 1/4 S BT.

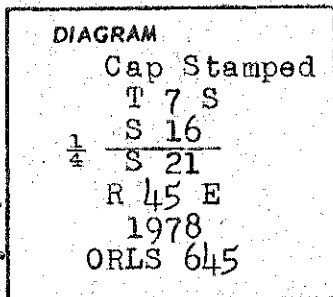

Description of corner evidence found:

At assumed corner location I found a volcanic stone 16 x 8 x 6 in. 12" in ground and with 1/4 faintly showing on the N face from which: A 22" fir bears S 45 W, 50 lks. dist. with face healed over; opened face, found 1/4 S. A stump hole and rotted wood bears N 21 W, 14 lks. dist.

Description of monument and accessories established to perpetuate the original location of this corner

I set a 2 1/2" x 30" galv. iron pipe w/brass cap stamped as shown above in the ground in mound of stone.

New bearing trees:

6" fir bears N 52 W, 12.70 ft. scribed 1/4 S S16 BT.
8" fir bears S 15 W, 59.0 ft. scribed 1/4 S S21 BT.

REGISTERED PROFESSIONAL LAND SURVEYOR

James H. Hambleton
8-21-78

OREGON
JULY 10, 1964
JAMES H. HAMBLETON
645

I hereby certify the above corner monument was re-established as herein described in August 1978.

Witnesses: *Leonard E. Allen*
Crew Chief
L. D. Shirk
Instrument Man

Office of County of
State of , I hereby certify that the within instrument was filed in this office for record on the day of
..... by
(COUNTY OFFICIAL) (DEPUTY)