


CERTIFIED RECORD OF LAND CORNER MONUMENTATION

History of original corner establishment:

Corner was established in 1882 by W.B. Barr under General Land Office Contract No. 443. Surveyor General's records state: Set post 4 ft. long 4" dia. 24" in ground for 1/4 sec. corner, mkd. 1/4 S on W side from which: A pine 8" dia. bears S 32 E, 15 lks. dist. mkd. 1/4 S BT. A pine 6" dia. bears S 05 W, 6 lks. dist. mkd. 1/4 S BT.

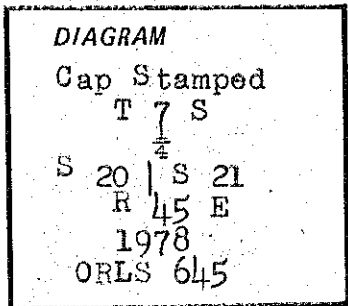

Description of corner evidence found:

At assumed corner location I found no trace of original corner as area has been logged and all evidence has been destroyed.

Description of monument and accessories I established to perpetuate the original location of this corner:

I determined this corner to be lost and re-established its location by single proportionate measurements. I set a 2 1/2" x 30" galv. iron pipe w/brass cap stamped as shown above in the ground in mound of stone.

New bearing trees:

8" fir bears N 60 E, 32.25 ft. scribed 1/4 S S21 BT.  
9" fir bears S 22 W, 37.67 ft. scribed 1/4 S S20 BT.

I hereby certify the above corner monument was re-established as herein described in August 1978.

Witnesses:

*Leonard E. Shew*  
Crew Chief  
*L.D. Shippy*  
Instrument Man

REGISTERED  
PROFESSIONAL  
LAND SURVEYOR

*James H. Hambleton*  
8-21-78

OREGON  
JULY 10, 1964  
JAMES H. HAMBLETON  
645

Office of..... County of.....  
State of....., I hereby certify that the within instrument was filed in this office  
for record on the..... day of....., 19.....

..... by .....  
(COUNTY OFFICIAL) (DEPUTY)

FILED 9-26-78  
BAKER COUNTY SURVEYOR  
SURVEY NO. 7-45-23