


CERTIFIED RECORD OF LAND CORNER MONUMENTATION

History of original corner establishment:

No previous history.

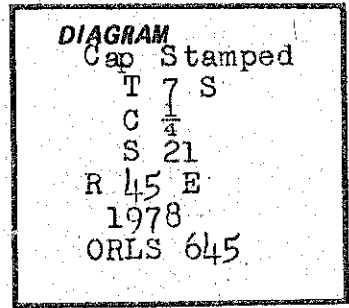

Description of corner evidence found:

None

Description of monument and accessories established to perpetuate the original location of this corner:

I set a 2 $\frac{1}{2}$ " x 30" galv. iron pipe w/brass cap stamped as shown above in the ground in mound of stone.

New bearing trees:

- 12" larch bears S 25 W, 17.35 ft. scribed C $\frac{1}{4}$ S S 21 BT.
- 12" larch bears S 83 W, 41.32 ft. scribed C $\frac{1}{4}$ S S 21 BT.

I hereby certify the above corner monument was re-established as herein described in August 1978.

Witnesses: Leonard E. Brown
Crew Chief

L. H. Shulby
Instrument Man

REGISTERED
PROFESSIONAL
LAND SURVEYOR

James H. Hambleton
8-21-78

OREGON
JULY 10, 1964
JAMES H. HAMBLETON
645

Office of..... County of.....
State of..... I hereby certify that the within instrument was filed in this office
for record on the..... day of....., 19.....
..... by

(COUNTY OFFICIAL) (DEPUTY)

FILED 9-26-78
BAKER COUNTY SURVEYOR
SURVEY NO. 2-45-24