


CERTIFIED RECORD OF LAND CORNER MONUMENTATION

6

History of original corner establishment:

No previous history.

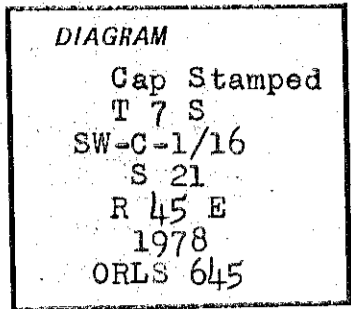

Description of corner evidence found:

None

Description of monument and accessories I established to perpetuate the original location of this corner:

I set a 2 1/2" x 30" galv. iron pipe w/brass cap stamped as shown above in the ground in mound of stone.

New bearing trees:

11" fir bears N 75 W, 3.50 ft. scribed 1/16 S 21 BT.

8" fir bears S 03 E, 19.09 ft. scribed 1/16 S 21 BT.

I hereby certify the above corner monument was re-established as herein described in August 1978.

Witnesses:

Leonard E. Steen
Crew Chief

L. D. Shirley
Instrument Man

REGISTERED
PROFESSIONAL
LAND SURVEYOR

James H. Hambleton
8-21-78

OREGON
JULY 10, 1964
JAMES H. HAMBLETON
645

Office of..... County of.....
State of....., I hereby certify that the within instrument was filed in this office
for record on the..... day of....., 19.....

..... by
(COUNTY OFFICIAL) (DEPUTY)

Form R6-7100-57 (9/71)

☆ GPO—798-276

FILED 9-26-78

BAKER COUNTY SURVEYOR

SURVEY NO. 7-45-25