


CERTIFIED RECORD OF LAND CORNER MONUMENTATION

History of original corner establishment:

Corner was established in 1882 by W.B. Barr under General Land Office Contract No. 443. Surveyor General's records state:
 Set post 4 ft. long 4" dia. 24" in ground for 1/4 sec. corn. mkd. 1/4 S on the N side from which:
 A tamarack 24" dia. bears S 10 W, 44 lks. dist. mkd. 1/4 S BT. cor.
 A tamarack 4" dia. bears N 05 W, 43 lks. dist. mkd. 1/4 S BT.

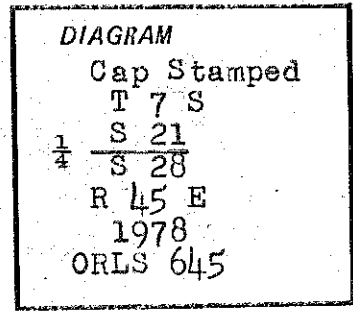

Description of corner evidence found:

At assumed corner location I found a tamarack post leaning in a tree with 1/4 S scribed on a face. On a previous occasion, I had been to this location and assumed a tamarack stump to possibly be the remains of the 24" bearing tree, but without an actual survey, stump was not confirmed. I now have determined through an actual survey, that I could not accept the stump; also the adjacent land owner, R.D. Thompson stated that during a land clearing operation, the original bearing tree was destroyed, thus leaving no trace of the original corner.

Description of monument and accessories I established to perpetuate the original location of this corner:

I determined this corner to be a lost corner, therefore I re-established the corner by single proportionate measurements. I set a 2 1/2" x 30" galv. iron pipe w/brass cap 28" in ground and stamped as shown above. There was no stone available in area.

New Bearing trees:

12" pine bears N 28 E, 66.58 ft. scribed 1/4 S S21 BT.
 14" larch bears S 55 W, 193.52 ft. scribed 1/4 S S28 BT.

I hereby certify the above corner monument was re-established as herein described in August 1978.

Witnesses:

Leonard E. Shuen
 Crew Chief

L. H. Fisher
 Instrument Man

REGISTERED
 PROFESSIONAL
 LAND SURVEYOR

James H. Hambleton
 8-21-78

OREGON
 JULY 10, 1964
 JAMES H. HAMBLETON
 645

Office of..... County of.....
 State of....., I hereby certify that the within instrument was filed in this office
 for record on the..... day of....., 19.....

..... by
 (COUNTY OFFICIAL) (DEPUTY)

FILED 9-26-78
 BAKER COUNTY SURVEYOR
 SURVEY NO. 7-45-28