


CERTIFIED RECORD OF LAND CORNER MONUMENTATION

History of original corner establishment:

No previous history.

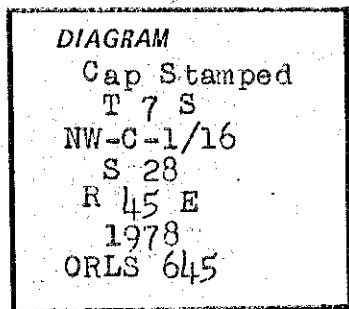

Description of corner evidence found:

None

Description of monument and accessories I established to perpetuate the original location of this corner:

I set a 2 1/2" x 30" galv. iron pipe w/brass cap stamped as shown above in the ground in mound of stone.

New bearing trees:

9" fir bears N 89 W, 30.16 ft. scribed 1/16 S 28 BT.
5" fir bears S 40 W, 15.87 ft. scribed 1/16 S 28 BT.

I hereby certify the above corner monument was re-established as herein described in August 1978.

REGISTERED
PROFESSIONAL
LAND SURVEYOR

James H. Hambleton
8-21-78

OREGON
JULY 10, 1964
JAMES H. HAMBLETON
645

Witnesses: *Leonard E. Green*
Crew Chief

L. D. Shyby
Instrument Man

Office of..... County of.....
State of....., I hereby certify that the within instrument was filed in this office
for record on the..... day of....., 19....

..... by
(COUNTY OFFICIAL) (DEPUTY)