


CERTIFIED RECORD OF LAND CORNER MONUMENTATION

History of original corner establishment:

No previous history.

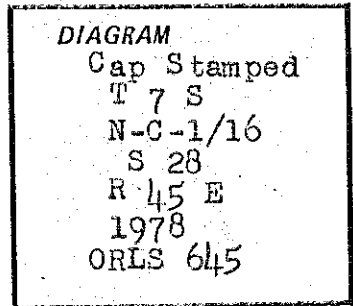

Description of corner evidence found:

None

Description of monument and accessories I established to perpetuate the original location of this corner:

I set a 2 1/2" x 30" galv. iron pipe w/brass cap stamped as shown above in the ground in mound of stone.

New bearing trees:

12" fir bears S 53 W, 100.33 ft. scribed 1/16 S 28 BT.
9" fir bears S 23 E, 72.50 ft. scribed 1/16 S 28 BT.

I hereby certify the above corner monument was re-established as herein described in August 1978.

REGISTERED PROFESSIONAL LAND SURVEYOR

James H. Hambleton
8-21-78

OREGON
JULY 10, 1964
JAMES H. HAMBLETON
645

Witnesses: *Lionel C. Stearns*
Crew Chief

P. D. Shelby
Instrument Man

Office of..... County of.....
State of....., I hereby certify that the within instrument was filed in this office
for record on the..... day of....., 19.....
..... by

(COUNTY OFFICIAL)

(DEPUTY)

Form R6-7100-57 (9/71)

☆ GPO—798-276

FILED 9-26-78
BAKER COUNTY SURVEYOR
SURVEY NO. 7-45-31