


CERTIFIED RECORD OF LAND CORNER MONUMENTATION

History of original corner establishment:

No previous history

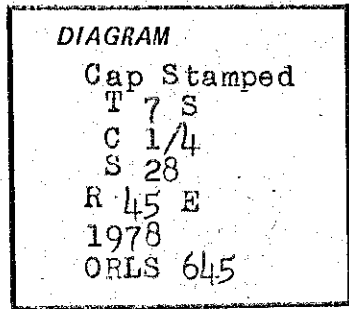

Description of corner evidence found:

None

Description of monument and accessories I established to perpetuate the original location of this corner:

I set a 2 1/2" x 30" galv. iron pipe w/brass cap stamped as shown above in ground in mound of stone.

New bearing trees:

7" larch bears N 07 E, 38.16 ft. scribed C 1/4 S 28 BT.

8" fir bears S 59 E, 31.64 ft. scribed C 1/4 S 28 BT.

I hereby certify the above corner monument was re-established as herein described in August 1978.

REGISTERED PROFESSIONAL LAND SURVEYOR

James H. Hambleton  
8-21-78

OREGON  
JULY 10, 1964  
JAMES H. HAMBLETON  
645

Witnesses:

Leonard E. Steen  
Crew Chief

L. D. Shilby  
Instrument Man

Office of..... County of.....  
State of....., I hereby certify that the within instrument was filed in this office  
for record on the..... day of....., 19.....

..... by .....  
(COUNTY OFFICIAL) (DEPUTY)

Form R6-7100-57 (9/71)

FILED 9-26-78  
BAKER COUNTY SURVEYOR  
SURVEY NO. 7-45-32