


CERTIFIED RECORD OF LAND CORNER MONUMENTATION

History of original corner establishment:

No previous history.

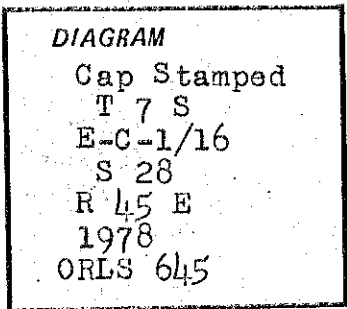

Description of corner evidence found:

None

Description of monument and accessories I established to perpetuate the original location of this corner:

I set a 2 1/2" x 30" galv. iron pipe w/brass cap stamped as show above in the ground with mound of stone around monument.

New Bearing trees:

12" fir bears S 25 W, 41.08 ft. scribed 1/16S S28 BT.
12" fir bears N 61 E, 94.27 ft. scribed 1/16S S 28 BT.

I hereby certify the above corner monument was re-established as herein described in August 1978.

REGISTERED
PROFESSIONAL
LAND SURVEYOR

James H. Hambleton
8-21-78

OREGON
JULY 10, 1964
JAMES H. HAMBLETON
645

Witnesses: *Leonard E. Aron*
Crew Chief

L. D. Shipes
Instrument Man

Office of..... County of.....
State of....., I hereby certify that the within instrument was filed in this office
for record on the..... day of....., 19.....

..... by
(COUNTY OFFICIAL) (DEPUTY)