


CERTIFIED RECORD OF LAND CORNER MONUMENTATION

17

History of original corner establishment:

Corner was established in 1882 by W.B. Barr under General Land Office Contract No. 443. Surveyor General's records state: Set iron rock 16 x 10 x 7" in ground for corner to Sec's 28, 29, 32 & 33 on hillside facing west, mkd. with 1 notch on S and 4 notches on E edges and a raised mound of rock alongside - pits impracticable.

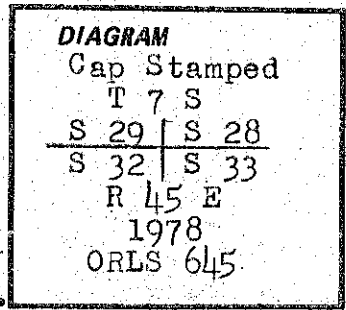

Description of corner evidence found:

At assumed corner location I found an iron rock 16 x 10 x 7 in. 8" in ground with 4 notches on E edge and 1 notch on S edge and a mound of stone along side.

Description of monument and accessories established to perpetuate the original location of this corner:

I set a 2 1/2" x 30" galv. iron pipe w/brass cap stamped as shown above and buried the 16 X 10 X 7 stone along side of monument in a large mound of stone and dirt.

New Bearing trees:

- 10" pine bears N 65 E, 55.16 ft. scribed T 7 S R 45 E S 28 BT.
  - 16" pine bears N 55 W, 45.50 ft. scribed T 7 S R 45 E S 29 BT.
  - 15" pine bears S 08 W, 76.75 ft. scribed T 7 S R 45 E S 32 BT.
- No tree available within contract limits in S 33.

REGISTERED  
PROFESSIONAL  
LAND SURVEYOR

*James H. Hambleton*  
8-21-78

OREGON  
JULY 10, 1964  
JAMES H. HAMBLETON  
645

I hereby certify the above corner monument was re-established as herein described in August 1978.

Witnesses: *Leonard C. [Signature]*  
Crew Chief

*L. D. [Signature]*  
Instrument Man

Office of..... County of.....  
State of..... I hereby certify that the within instrument was filed in this office  
for record on the..... day of..... 19.....

..... by .....  
(COUNTY OFFICIAL) (DEPUTY)

Form R6-7100-57 (9/71)

GPO-798-276

FILED 9-26-78  
BAKER COUNTY SURVEYOR  
SURVEY NO. 7-45-36