


(19)

CERTIFIED RECORD OF LAND CORNER MONUMENTATION

History of original corner establishment:

Corner was established in 1882 by W.B. Barr under General Land Office Contract No. 443. Surveyor General's records state:
Set basalt rock 18 x 14 x 6 in. 12 in. in ground for $\frac{1}{4}$ sec. corner marked $\frac{1}{4}$ on the N side from which:
A pine 12" dia. bears S 76 E, 115 lks. dist. mkd. $\frac{1}{4}$ S BT.
A pine 6" dia. bears N 34 E, 80 lks. dist. mkd. $\frac{1}{4}$ S BT.

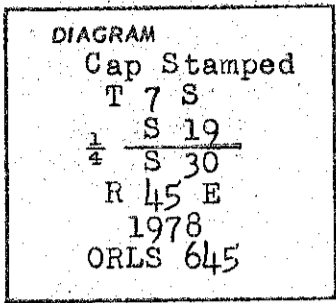

Description of corner evidence found:

At assumed corner location I found a basalt stone 18 x 14 x 6 in. lying on the surface though I could find no markings on the stone from which:
A 42" pine now and at the time of the placement of the corner was approx. 36" instead of 6", bears N 34 E, 80 lks. dist.; I opened the face to verify and found $\frac{1}{4}$ S; did not open lower face.
A rotted pine approx. 14" dia. bears S 76 E, 115 lks. dist.; I found the blaze portion with $\frac{1}{4}$ S BT on pitch blaze; badly weathered.

Description of monument and accessories I established to perpetuate the original location of this corner

I set a 2 $\frac{1}{2}$ " x 30" galv. iron pipe w/brass cap stamped as shown above, with the 18 x 14 x 6 in. stone in base of large mound of stone and dirt around the monument.

New bearing trees:

12" pine bears N 63 E, 62.5 ft. (slope dist.) scribed $\frac{1}{4}$ S S19 BT.
10" pine bears S 01 W, 117.5 ft. (horiz. dist.) scribed $\frac{1}{4}$ S S30 BT.

REGISTERED
PROFESSIONAL
LAND SURVEYOR

James H. Hambleton
8-21-78

OREGON
JULY 10, 1964
JAMES H. HAMBLETON
645

I hereby certify the above corner monument was re-established as herein described in August 1978.

Witnesses: *Leonard E. Green*
Crew Chief

L. D. Shalup
Instrument Man

Office of County of
State of , I hereby certify that the within instrument was filed in this office
for record on the day of
..... by
(COUNTY OFFICIAL) (DEPUTY)