


CERTIFIED RECORD OF LAND CORNER MONUMENTATION

History of original corner establishment:

No previous history.

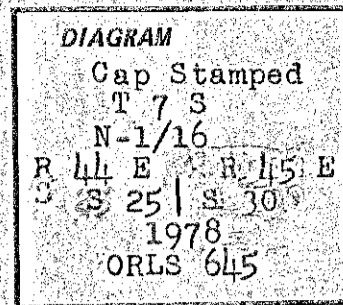

Description of corner evidence found:

None

Description of monument and accessories established to perpetuate the original location of this corner:

I set a 2 1/2" x 30" galv. iron pipe w/brass cap stamped as shown above, in the ground and placed a large mound of stone and dirt around the monument.

New bearing trees:

4" pine bears N 47 W, 37.50 ft. scribed 1/16S S25 BT.
8" pine bears S 05 20 E, 15.29 ft. scribed 1/16S S30 BT.

I hereby certify the above corner monument was re-established as herein described in August 1978.

Witnesses: Leonard E. Green
Crew Chief

L. D. Sherrill
Instrument Man

REGISTERED
PROFESSIONAL
LAND SURVEYOR

James H. Hambleton
8-21-78

OREGON
JULY 10, 1964
JAMES H. HAMBLETON
645

Office of..... County of.....
State of..... I hereby certify that the within instrument was filed in this office
for record on the..... day of....., 19.....
..... by
(COUNTY OFFICIAL) (DEPUTY)

Form R6-7100-57 (9/71)

☆ GPO-798-276

FILED 9-26-78
BAKER COUNTY SURVEYOR
SURVEY NO. 7-45-39