


CERTIFIED RECORD OF LAND CORNER MONUMENTATION

22

History of original corner establishment:

Corner was established in 1882 by W.B. Barr under General Land Office Contract No. 443. Surveyor General's records state: Set a boulder rock 12 x 8 x 8 in. marked 1/4 on W face from which: A fir 3" dia. bears S 48 W, 5 lks. dist marked 1/4 S BT. A fir 3" dia. bears S 81 E, 4 lks. dist. marked 1/4 S BT.

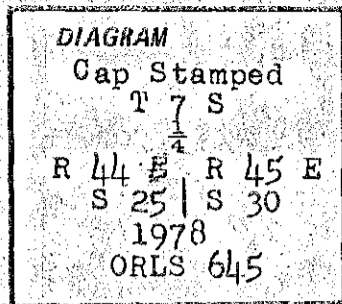

Not mkt according to this diagram J.M.M.

Description of corner evidence found:

Made extensive search in area; determined creek had flooded the area - possibly by cloud burst; found no trace of corner stone nor the bearing trees.

Description of monument and accessories established to perpetuate the original location of this corner:

After careful search, I determined this corner to be a lost corner, therefore relocated the corner by single proportionate measurements of which I set a 2 1/2" x 30" galv. iron pipe w/brass cap stamped as shown above, in the ground and placed a large mound of stone and dirt around the monument.

New bearing trees:

6" fir bears N 68 W, 47.42 ft. scribed 1/4 S S25 BT.
10" fir bears S 37.08 ft. scribed 1/4 S S30 BT.

REGISTERED PROFESSIONAL LAND SURVEYOR

James H. Hambleton
8-21-78

OREGON
JULY 10, 1984
JAMES H. HAMBLETON
645

I hereby certify the above corner monument was re-established as herein described in August 1978.

Witnesses: *Leonard E. Green*
Crew Chief

L. D. Shirley
Instrument Man

Office of..... County of.....
State of..... I hereby certify that the within instrument was filed in this office for record on the..... day of....., 19.....
..... by
(COUNTY OFFICIAL) (DEPUTY)

Form R6-7100-57 (9/71)

☆ GPO-798,276

FILED 9-26-78
BAKER COUNTY SURVEYOR
SURVEY NO. 7-45-41

2-4-5