


CERTIFIED RECORD OF LAND CORNER MONUMENTATION

History of original corner establishment: CORNER ESTABLISHED IN 1882
BY W. B. BARR UNDER G.L.O. CONTRACT NO. 443.

SURVEYOR GENERAL'S RECORDS STATE: SET LIMESTONE
18x10x8 INS. 12 INCHES IN GROUND ON HILLSIDE FACING EAST
FOR $\frac{1}{4}$ SEC. CORNER MARKED $\frac{1}{4}$ ON THE WEST SIDE
FROM WHICH

A PINE 28 IN DIAM. BEARS S86°W 43 LKS. DIST.
MARKED $\frac{1}{4}$ S. B.T.

A PINE 10" DIAM BEARS S54°E 53 LKS. DIST. MARKED $\frac{1}{4}$ S BT

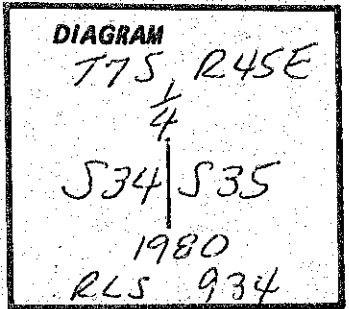

Description of corner evidence found:

FND. OBT, NOW A 28" PINE SNAG W/FACE AND SCRIBES " $\frac{1}{4}$ S BT" CLEARLY
VISIBLE; BEARS S86°W 28.4 FT. (43 LKS.)

SNAG IS ROTTED BUT STILL STANDING.

Description of monument and accessories I established to perpetuate the

original location of this corner: AT POSITION DETERMINED FROM SW. BT I SET A 2"x30"
GALV. IRON PIPE W/ BRASS CAP STAMPED AS SHOWN ABOVE, FROM WHICH:

NEW BT, 8" PINE, SCRIBED " $\frac{1}{4}$ S 35 BT" BEARS N34½°E, 22.2 FT.

NEW BT, 7" PINE, SCRIBED " $\frac{1}{4}$ S 34 BT" BEARS N88°W, 28.0 FT.

I SET THE 2" PIPE 28" IN GROUND AND SET STONES AROUND IT.

I SET A STEEL POST 3' S. OF COR. W/SIGN 54-4.

I PAINTED A RED BAND AROUND THE BT'S AND TAGGED THEM W/SIGNS 54-3.

REGISTERED
PROFESSIONAL
LAND SURVEYOR

Victor M. McLind

OREGON
JULY 17, 1970
VICTOR M. McLIND
934

I HEREBY CERTIFY THE ABOVE CORNER
MONUMENT WAS RE-ESTABLISHED AS HEREIN
DESCRIBED ON MAY 26, 1980.

WITNESS: *Doug McKind*

Office of..... County of.....

State of..... I hereby certify that the within instrument was filed in this office

for record on the..... day of....., 19.....

..... by

(COUNTY OFFICIAL)

(DEPUTY)