


CERTIFIED RECORD OF LAND CORNER MONUMENTATION

History of original corner establishment: CORNER ESTABLISHED IN 1882 UNDER G.L.O. CONTRACT NO. 443, BY W.B. BARR.

SURVEYOR GENERAL'S RECORDS STATE:

SET VOLCANIC ROCK 16x14x5 IN 11 INCHES IN GROUND FOR $\frac{1}{4}$ SEC. CORNER MARKED $\frac{1}{4}$ ON THE WEST SIDE AND RAISED MOUND OF ROCK ALONGSIDE. PITS IMPRACTICABLE.

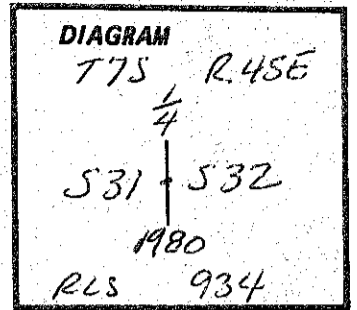

Description of corner evidence found: NONE

Description of monument and accessories I established to perpetuate the original location of this corner:

AT PROPORTIONED POSITION I SET A 2" x 30" GALV. IRON PIPE W/BRASS CAP STAMPED AS SHOWN ABOVE, FROM WHICH:

NEW BT, 8" PINE, SCRIBED " $\frac{1}{4}$ S31 BT" BEARS N 38 $\frac{3}{4}$ W, 218.3 FT.

NEW BT, 7" PINE, SCRIBED " $\frac{1}{4}$ S 32 BT" BEARS N 77 $\frac{1}{2}$ E 225.4 FT.

I SET THE 2" PIPE 26" IN GROUND AND SET STAKES AROUND IT.

I SET A STEEL POST 3' N. OF CORNER W/SIGN 54-4

I PAINTED A RED BAND AROUND BOTH BT'S AND TAGGED THEM W/SIGNS 54-3

REGISTERED PROFESSIONAL LAND SURVEYOR

Victor M. McLind
OREGON
JULY 17, 1970
VICTOR M. McLIND
934

I HEREBY CERTIFY THE ABOVE CORNER MONUMENT WAS RE-ESTABLISHED AS HEREIN DESCRIBED ON JUNE 24, 1980

WITNESS: *Doug McLind*

Office of..... County of.....

State of....., I hereby certify that the within instrument was filed in this office for record on the..... day of....., 19.....

..... by

(COUNTY OFFICIAL)

(DEPUTY)