

CERTIFIED RECORD OF LAND CORNER MONUMENTATION

History of original corner establishment: CORNER ESTABLISHED IN 1882
By W.B. BARR UNDER G.L.O. CONTRACT No. 443

SURVEYOR GENERAL'S RECORDS READ:


SET BASALT ROCK 16x9x4 IN., 11 INCHES IN GROUND FOR
CORNER TO SEC. 26, 27, 34, 35, MARKED WITH 1 NOTCH ON
SOUTH AND 2 NOTCHES ON THE EAST EDGES, FROM WHICH:

A FIR 24 IN DIAM. BEARS N 84° E 64 LKS. DIST.
MARKED "T75 R45E S26 BT"

A PINE 20 IN DIAM. BEARS N 19° W 98 LKS MARKED "T75 R45E S27 BT"

A PINE 14 IN DIAM. BEARS S 35° W 48 LKS DIST. MARKED "T75 R45E S34 BT"

A PINE 20 IN DIAM. BEARS S 20° E 16 LKS DIST MARKED "T75 R45E S35 BT"

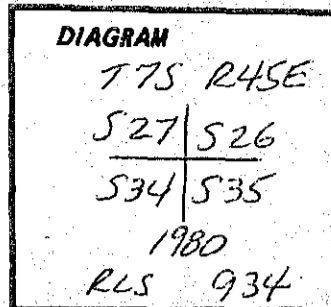

Description of corner evidence found:

OBT, PINE, NOW ROTTED LOG ON GROUND w/SERIBES "T75 R45E S27 BT"
BEARS N 19° W 64.7 FT. (98 LKS.)

OBT, PINE, NOW ROTTED STUMP, w/SERIBES "BT", BEARS S 35° W 31.7 FT. (48 LKS.)

OBT, PINE, NOW BADLY ROTTED STUMP, BEARS S 18° E 10.6 FT. (REC. S 20° E 16 LKS.)
NO MARKS VISIBLE.

ORIG. STONE MON. NOT FND.

Description of monument and accessories I established to perpetuate the

original location of this corner: AT LOCATION ESTABLISHED BY 3 FND. OBT'S, I SET
A 2" x 30" GALV. IRON PIPE w/BR. CAP STAMPED AS SHOWN ABOVE, FROM WHICH:

NEW BT, 8" PINE, SERIBED "T75 R45E S26 BT" BEARS N 69 1/2° E, 23.9 FT.

NEW BT, 7" PINE, SERIBED "T75 R45E S27 BT" BEARS N 17° W, 17.5 FT.

NEW BT, 9" PINE, SERIBED "T75 R45E S34 BT" BEARS S 68 1/2° W, 16.9 FT.

NEW BT, 9" PINE, SERIBED "T75 R45E S35 BT" BEARS S 61 1/2° E, 48.0 FT.

I SET THE 2" PIPE 25" IN GROUND AND SET STONES AROUND IT.

I PAINTED THE BT'S WITH A RED BAND AND TAGGED THEM w/SIGNS 54-3

I SET A STEEL POST 3' FROM COR. w/SIGN 54-4

REGISTERED
PROFESSIONAL
LAND SURVEYOR

Victor M. McLind

OREGON
JULY 17, 1970
VICTOR M. MCLIND
934

I HEREBY CERTIFY THE ABOVE CORNER MONUMENT
WAS RE-ESTABLISHED AS HEREIN DESCRIBED ON
MAY 6, 1980

WITNESS: *Doug McFend*

Office of..... County of.....
State of..... I hereby certify that the within instrument was filed in this office
for record on the..... day of....., 19.....
..... by

(COUNTY OFFICIAL)

(DEPUTY)

Form R6-7100-57 (9/71)

FILED Aug. 11, 1980
BAKER COUNTY SURVEYOR
SURVEY NO. 7-45-48