


CERTIFIED RECORD OF LAND CORNER MONUMENTATION

History of original corner establishment: *NONE*

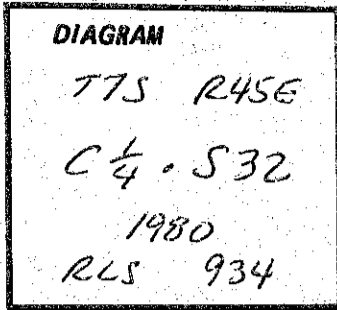

Description of corner evidence found: *NONE*

Description of monument and accessories established to perpetuate the original location of this corner: *AT CALCULATED POSITION I SET A 2" x 30" GALV. IRON PIPE W/ BRASS CAP STAMPED AS SHOWN ABOVE, FROM WHICH:*
NEW BT, 7" FIR, SERIBED "C 1/4 S 32 BT" BEARS N 7° E, 22.0 FT.
NEW BT, 12" PINE, SERIBED "C 1/4 S 32 BT" BEARS S 49° E, 40.5 FT.

I SET THE 2" PIPE 27" IN GROUND AND SET STONES AROUND IT.
I SET A STEEL POST 3' N. OF CORNER W/SIGN 54-9
I PAINTED A RED BAND AROUND BOTH BT'S AND TAGGED THEM W/SIGN 54-3

REGISTERED
 PROFESSIONAL
 LAND SURVEYOR

Victor M. McFend

OREGON
 JULY 17, 1970
 VICTOR M. MCLIND
 934

I HEREBY CERTIFY THE ABOVE CORNER MONUMENT WAS ESTABLISHED AS HEREIN DESCRIBED ON JUNE 24, 1980.

WITNESS: *Doug McFend*

Office of..... County of.....
 State of....., I hereby certify that the within instrument was filed in this office for record on the..... day of....., 19.....
 by
 (COUNTY OFFICIAL) (DEPUTY)