


X-8 775 R45E

CERTIFIED RECORD OF LAND CORNER MONUMENTATION

History of original corner establishment: *NONE*

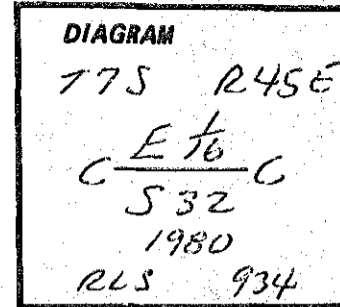

Description of corner evidence found: *NONE*

Description of monument and accessories I established to perpetuate the original location of this corner: *AT CALCULATED POSITION I SET A 2" x 30" GALV. IRON PIPE W/ BRASS CAP STAMPED AS SHOWN ABOVE, FROM WHICH:*

*NEW BT, 10" PINE, SCRIBED "CE $\frac{1}{16}$ S32 BT" BEARS S0 $\frac{1}{4}$ °W, 19.4 FT.
NEW BT, 9" PINE, SCRIBED "CE $\frac{1}{16}$ S32 BT" BEARS S79°E, 39.9 FT.*

*I SET THE 2" PIPE 27" IN GROUND AND SET STONES AROUND IT.
I SET A STEEL POST 3' N. OF COR. W/SIGN 54-2 & 54-9 AND A STEEL POST 3' E. OF COR. W/SIGN 54-2
I TAGGED BOTH BT'S W/SIGN 54-3 AND PAINTED A RED BAND AROUND THEM.*

REGISTERED
PROFESSIONAL
LAND SURVEYOR

Victor M. McLind

OREGON
JULY 17, 1970
VICTOR M. McLIND
934

I HEREBY CERTIFY THE ABOVE CORNER MONUMENT WAS ESTABLISHED AS HEREIN DESCRIBED ON JUNE 26, 1980.

WITNESS: Doug McFerd

Office of..... County of.....
 State of....., I hereby certify that the within instrument was filed in this office
 for record on the..... day of....., 19.....
 by.....
 (COUNTY OFFICIAL) (DEPUTY)

Form R6-7100-57 (9/71)

FILED Aug. 11, 1980 ☆ GPO-799-276
 BAKER COUNTY SURVEYOR
 SURVEY NO. 7-45-51