


CERTIFIED RECORD OF LAND CORNER MONUMENTATION

History of original corner establishment: *NONE*

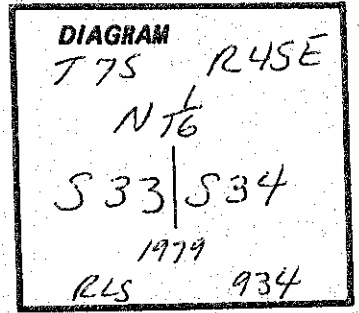

Description of corner evidence found: *NONE*

Description of monument and accessories I established to perpetuate the original location of this corner: *AT PROPORTIONED LOCATION I SET A 2" x 30" GALV. IRON PIPE w/ BRASS CAP STAMPED AS SHOWN ABOVE, FROM WHICH:*

NEW BT, 11" FIR, SCRIBED "N $\frac{1}{16}$ S 34 BT" BEARS S 10 $\frac{3}{4}$ ° E, 19.1 FT.

NEW BT, 7" FIR, SCRIBED "N $\frac{1}{16}$ S 33 BT" BEARS N 48° W, 50.7 FT.

I SET THE 2" PIPE 27" IN GROUND AND SET STONES AROUND IT.

I SET A STEEL POST 3' N. OF COR. w/ SIGNS 54-2 & 54-9 ATTACHED.

I PAINTED A RED BAND AROUND BTs AND TAGGED THEM w/ SIGNS 54-3

REGISTERED
PROFESSIONAL
LAND SURVEYOR

Victor M. McLind

OREGON
JULY 17, 1970
VICTOR M. McLIND
934

I HEREBY CERTIFY THE ABOVE CORNER MONUMENT WAS ESTABLISHED AS HEREIN DESCRIBED ON NOVEMBER 13, 1979.

WITNESS: *George P. Barbell*

Office of..... County of.....
State of..... I hereby certify that the within instrument was filed in this office
for record on the..... day of....., 19.....
..... by
(COUNTY OFFICIAL) (DEPUTY)