


CERTIFIED RECORD OF LAND CORNER MONUMENTATION

A-7 T85 R45E

History of original corner establishment: CORNER ESTABLISHED IN 1873  
BY ARIN & WALDEN UNDER G.L.D. CONTRACT.  
SURVEYOR GENERAL'S RECORDS STATE:  
SET BASALT STONE 18x14x7, 8 IN. IN GROUND FOR  
1/4 SEC. COR.

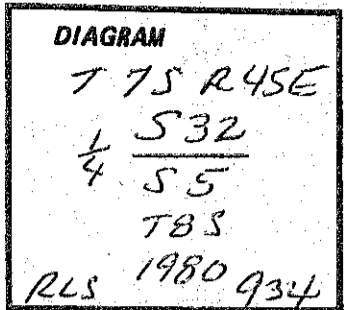

Description of corner evidence found: NONE

Description of monument and accessories I established to perpetuate the original location of this corner: AT PROPORTIONED LOCATION I SET A 2" x 30" GALV. IRON PIPE W/ BRASS CAP STAMPED AS SHOWN ABOVE, FROM WHICH I  
NEW BT, 10" PINE, SCRIBED "1/4 S 5 BT" BEARS S 30° E, 32.8 FT.  
NEW BT, 11" PINE, SCRIBED "1/4 S 32 BT" BEARS N 11 1/4° E, 107.6 FT.  
I SET THE 2" PIPE 15" IN GROUND AND BUILT A STONE MOUND AROUND IT.  
I SET A STEEL POST 3' E. OF COR. W/ SIGN 54-4  
I PAINTED A RED BAND AROUND BOTH BT'S, AND TAGGED THEM W/ SIGN 54-3

I HEREBY CERTIFY THE ABOVE CORNER MONUMENT WAS RE-ESTABLISHED AS HEREIN DESCRIBED ON JUNE 25, 1980.

REGISTERED  
PROFESSIONAL  
LAND SURVEYOR

*Victor M. McLind*

OREGON  
JULY 17, 1970  
VICTOR M. McLIND  
934

WITNESS: *Doug McFird*

Office of..... County of.....  
State of....., I hereby certify that the within instrument was filed in this office  
for record on the..... day of....., 19.....  
..... by .....

(COUNTY OFFICIAL)

(DEPUTY)

Form R6-7100-57 (9/71)

FILED Aug 11, 1980  
BAKER COUNTY SURVEYOR  
SURVEY NO. 7-45-57  
8-45-37

☆ GPO-798-276