


CERTIFIED RECORD OF LAND CORNER MONUMENTATION

History of original corner establishment: CORNER ESTABLISHED IN 1873
BY BRIN & WALDEN UNDER G.L.O. CONTRACT.
SURVEYOR GENERAL'S RECORDS STATE:
SET BASALT STONE 12.8.6. 8" IN GROUND FOR
CORNER TO SEC. 32, 33, 5, 4

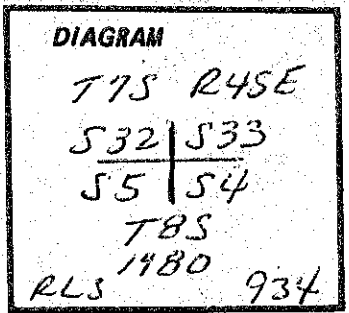

Description of corner evidence found: FOUND STONE 12"x 8"x 6", NO MARKS WHICH
COULD BE DEFINITELY IDENTIFIED, LYING IN MOUND OF STONE. ALSO FND. OLD
RUSTED METAL POSTER INDICATING SEC. COR 32, 33, 4, 5, DATED 5-6-29,
LYING UNDER THE STONE. I ACCEPT THIS AS BEST EVIDENCE AVAILABLE OF ORIG.
CORNER LOCATION.

Description of monument and accessories I established to perpetuate the
original location of this corner: IN PLACE OF THE FND. STONE I SET A "2" X 30" GALV.
IRON PIPE W/ BRASS CAP STAMPED AS SHOWN ABOVE, FROM WHICH:
NEW BT, 10" PINE, SCRIBED "T75 R45E S32 BT" BEARS N59°W, 291.3 FT.
NEW BEARING OBJECT, A BOULDER 30"x 30"x 26" HIGH, CHISELED "B0" ON FACE,
BEARS S73½°W 183.3 FT.
NEW BEARING OBJECT, A BOULDER 20"x 32"x 20" HIGH, CHISELED "B0" ON FACE,
BEARS S71½°E 24.7 FT.
NEW BEARING OBJECT, A BOULDER 16"x 24"x 14" HIGH, CHISELED "B0" ON FACE,
BEARS N58½°E, 76.0 FT.
I SET THE "2" PIPE 15" IN GROUND AND BUILT A MOUND OF STONE AROUND IT.
I SET A STEEL POST 3'E. OF COR. W/SIGN 54.4. I TAGGED THE BT. W/SIGN
54-3 AND PAINTED A RED BAND AROUND IT.

REGISTERED
PROFESSIONAL
LAND SURVEYOR
Victor M. McLind
OREGON
JULY 17, 1970
VICTOR M. McLIND
934

I HEREBY CERTIFY THE ABOVE CORNER MONUMENT
WAS RE-ESTABLISHED AS HEREIN DESCRIBED ON
JUNE 24, 1980.

WITNESS: *Doug McFerd*

Office of..... County of.....
State of....., I hereby certify that the within instrument was filed in this office
for record on the..... day of....., 19.....
..... by
(COUNTY OFFICIAL) (DEPUTY)